
PLAT OF SURVEY LOT 16 OF THE FIRST ADDITION TO LAKE GENEVA AIRE ESTATES, A SUBDIVISION

LOCATED IN PART OF THE NW 1/4 OF THE SE 1/4 OF SECTION 4, TOWN 1 NORTH, RANGE 18 EAST, VILLAGE OF BLOOMFIELD, WALWORTH COUNTY, WISCONSIN

NORTH BLOOMFIELD ROAD {66' WIDE R.O.W.}

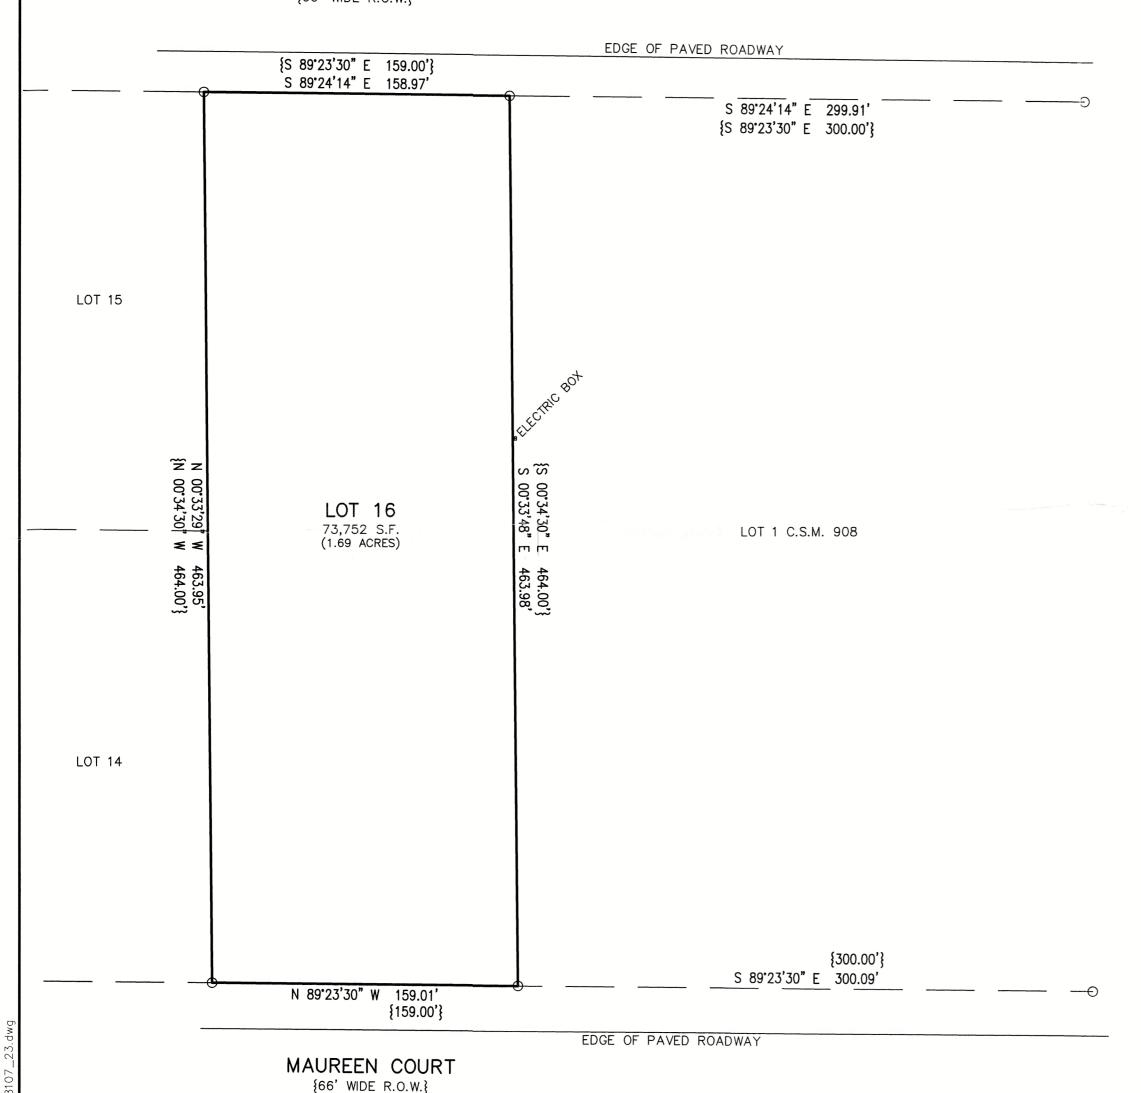

LEGEND

O = FOUND IRON PIPE STAKE

 $\{XXX\}$ = RECORDED AS

IE BEIVE

NOTE: COPIES OF THIS MAP TO WHICH THE FOLLOWING CERTIFICATE WILL APPLY SHOW THE SURVEYOR'S ORIGINAL SEAL AND SIGNATURE IN RED INK. COPIES BY ANY OTHER MEANS MAY HAVE ALTERATIONS WHICH DO NOT REPRESENT THE SURVEYOR'S WORK PRODUCT.

I HEREBY CERTIFY THAT THE ABOVE DESCRIBED PROPERTY HAS BEEN SURVEYED UNDER MY DIRECTION AND THAT THE ABOVE MAP IS A TRUE REPRESENTATION THEREOF AND SHOWS THE SIZE AND LOCATION OF THE PROPERTY AND ITS EXTERIOR BOUNDARIES. THIS SURVEY IS MADE FOR THE USE OF THE PRESENT OWNERS OF THE PROPERTY, AND ALSO THOSE WHO PURCHASE, MORTGAGE, OR GUARANTEE THE TITLE THERETO WITHIN ONE YEAR FROM THE DATE HEREOF.

3/3/2023

CHRISTOPHER A. HODGES P.L.S. 2760

HODGES

PROJECT NO. 8107.23 DATE: 03/03/2023

SHEET NO.

1 OF 1

MAP SCALE IN FEET - ORIGINAL 1"=50'

REVISIONS