


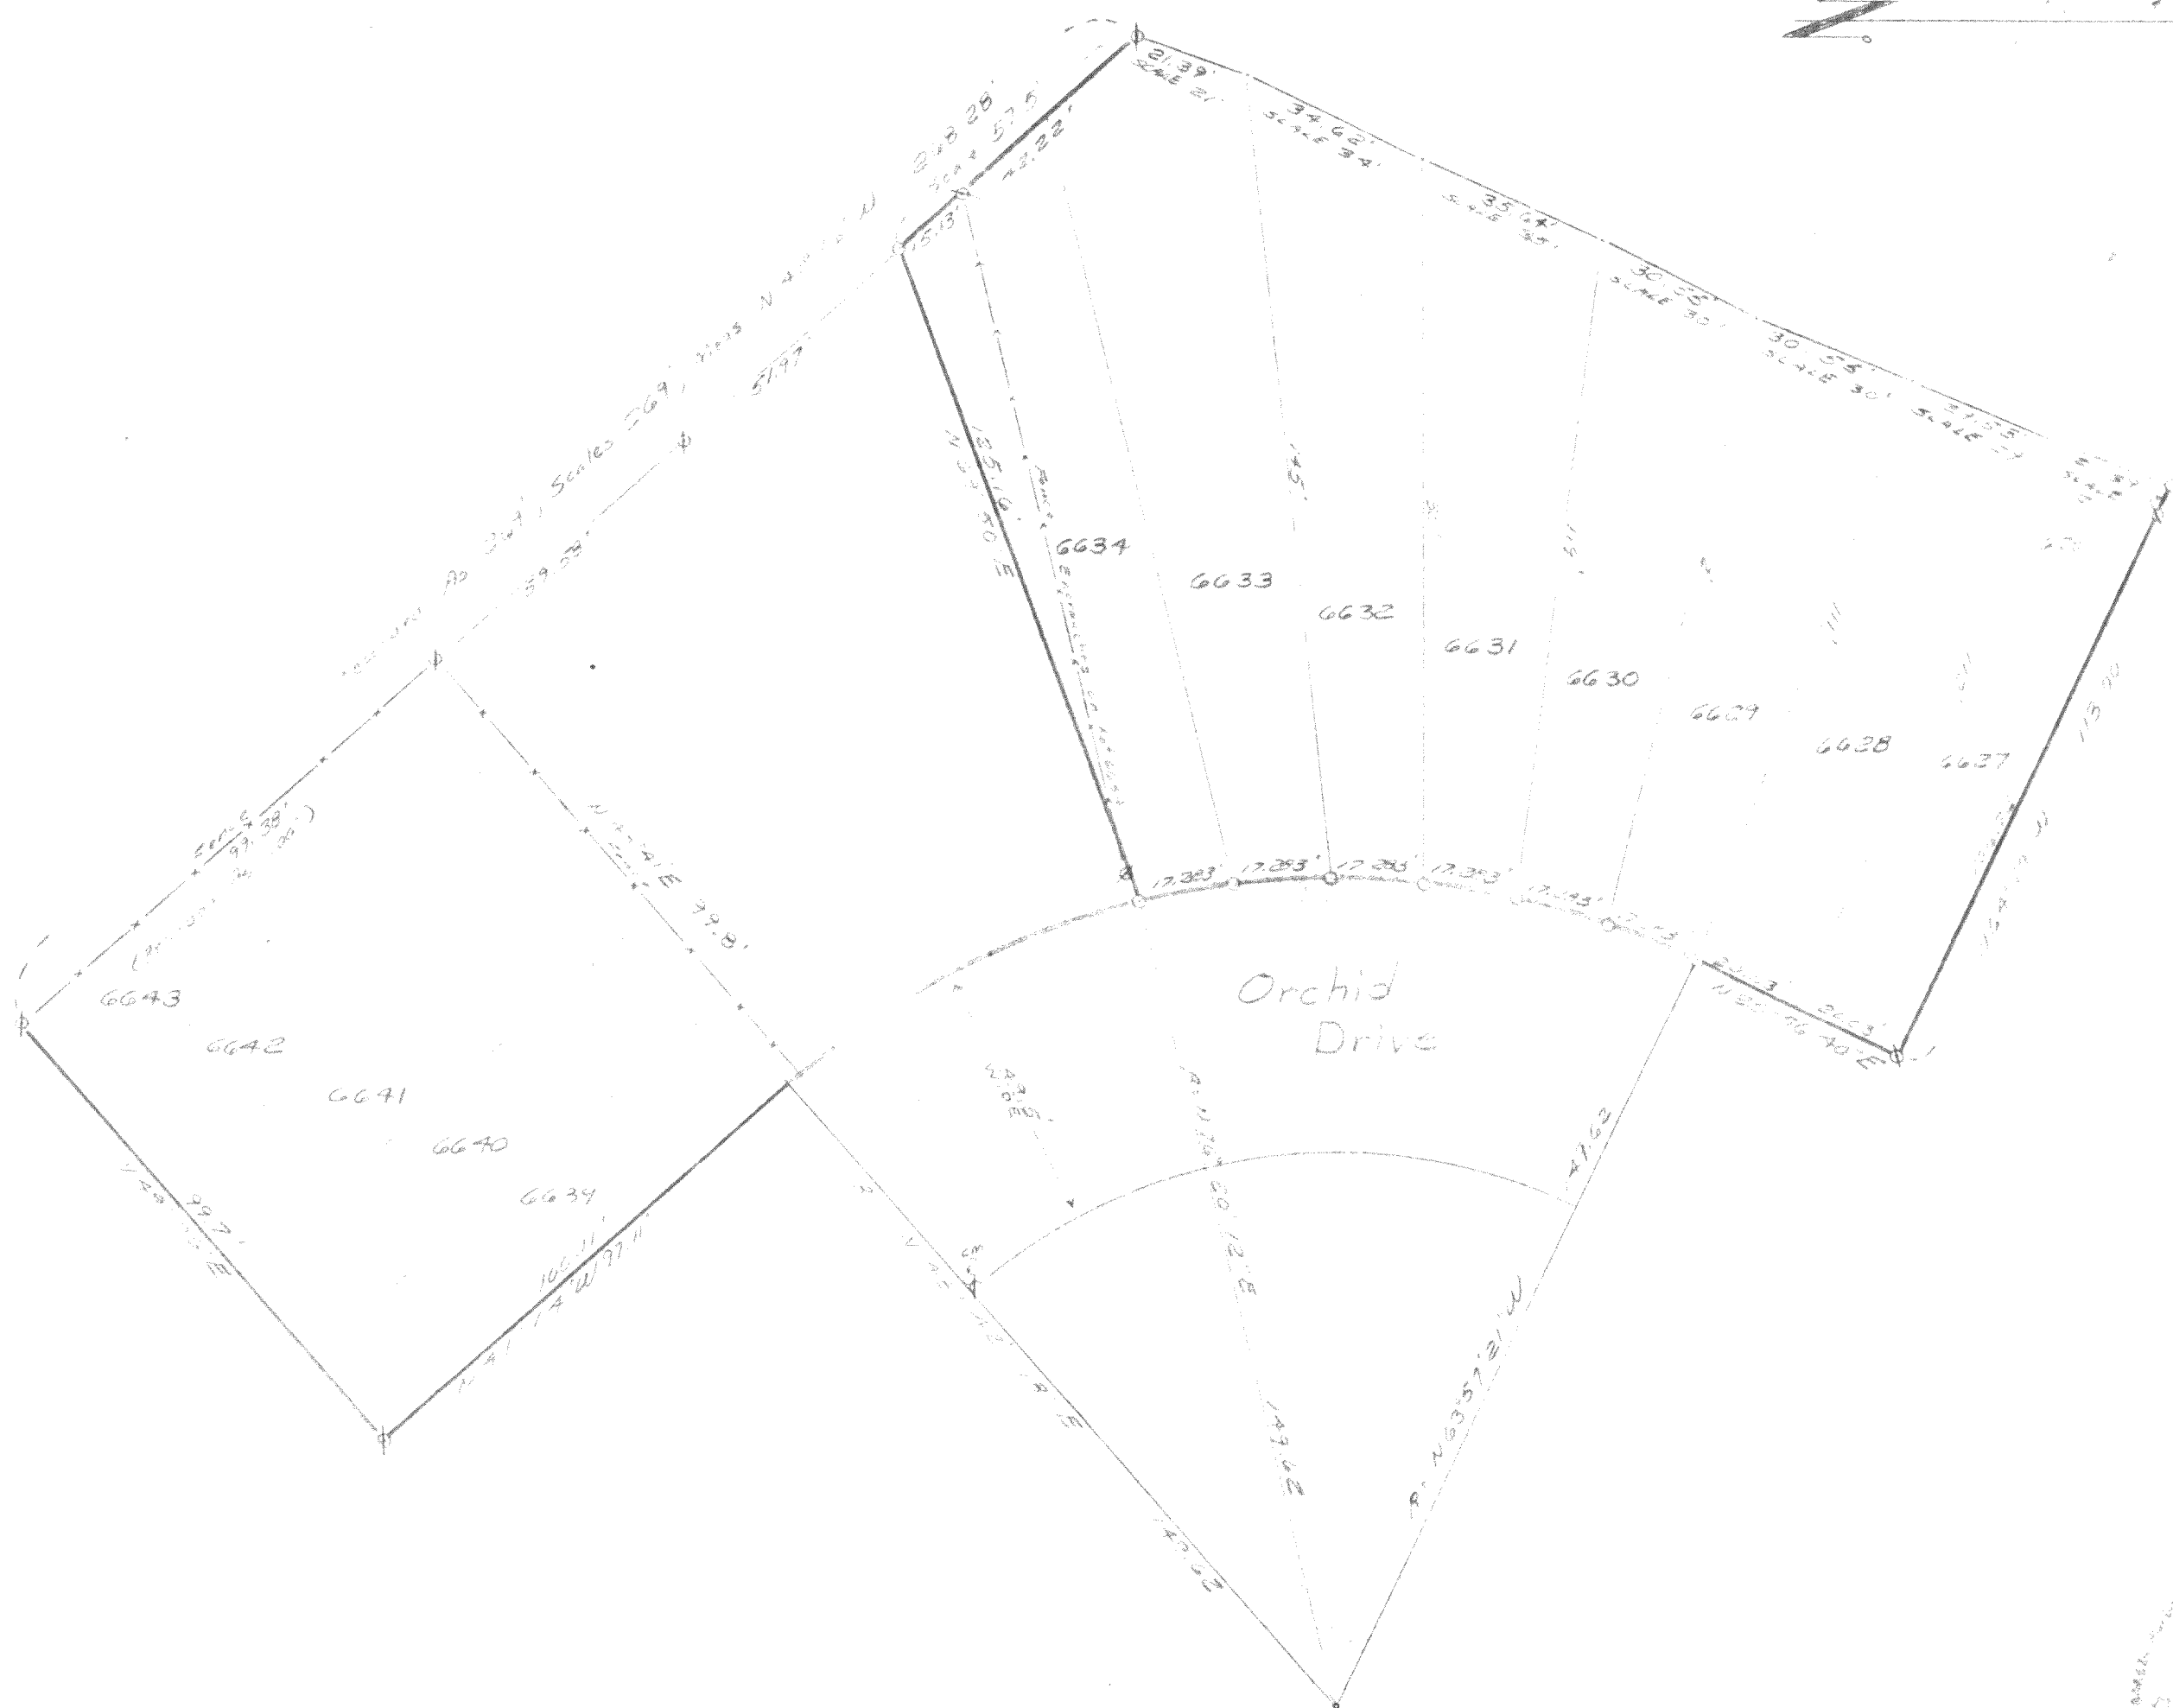

R = Iron Pipe Found
C = Iron Pipe Cap

MPL 1047
1450

PLAT OF SURVEY **OF**

Lots 6627, 6628, 6629, 6630, 6631, 6632,
6633, 6634, 6635, 6636, 6637, 6638, 6639, 6640, 6641, 6642, 6643
Located in the Northwest 1/4 of Section 15,
Township 1 North, Range 8 East, Marathon County
Wisconsin. Lots are plotted on Map of Section 4
Pot Lake.

Lloyd Jensen
SURVEYOR

SCALE 1" = 30'

DATE 27 June 1973
MPL 1047 1450