

W 238 S 3712 BIG BEND ROAD
WAUKESHA, WIS. 53186

TELEPHONE
542-5616

RONALD H. ZIMMERMAN
REGISTERED LAND SURVEYOR

PLAT OF SURVEY

FOR

WAUKESHA SAVINGS & LOAN



CERTIFICATION


STATE OF WISCONSIN)
COUNTY OF WAUKESHA) SS

I, RONALD H. ZIMMERMAN, REGISTERED LAND SURVEYOR, DO HEREBY CERTIFY THAT I HAVE MADE A SURVEY OF LOTS 8347 THRU 8351, MAP OF SECTION 5, PELL LAKE, TOWN OF BLOOMFIELD AND THE EXISTING BUILDING AND IMPROVEMENTS LOCATED THEREON AND THAT THE PLAT HEREWITH DRAWN IS A CORRECT REPRESENTATION OF SAID SURVEY.

DATE MAY 7, 1974

RONALD H. ZIMMERMAN

S - 868

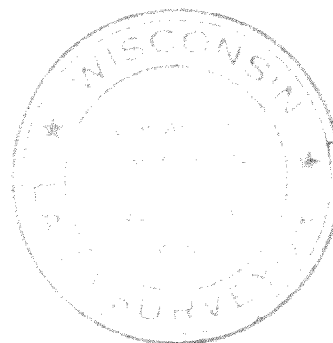

118-429