



 SCALE - 1" = 20'
 O = IRON PIPE

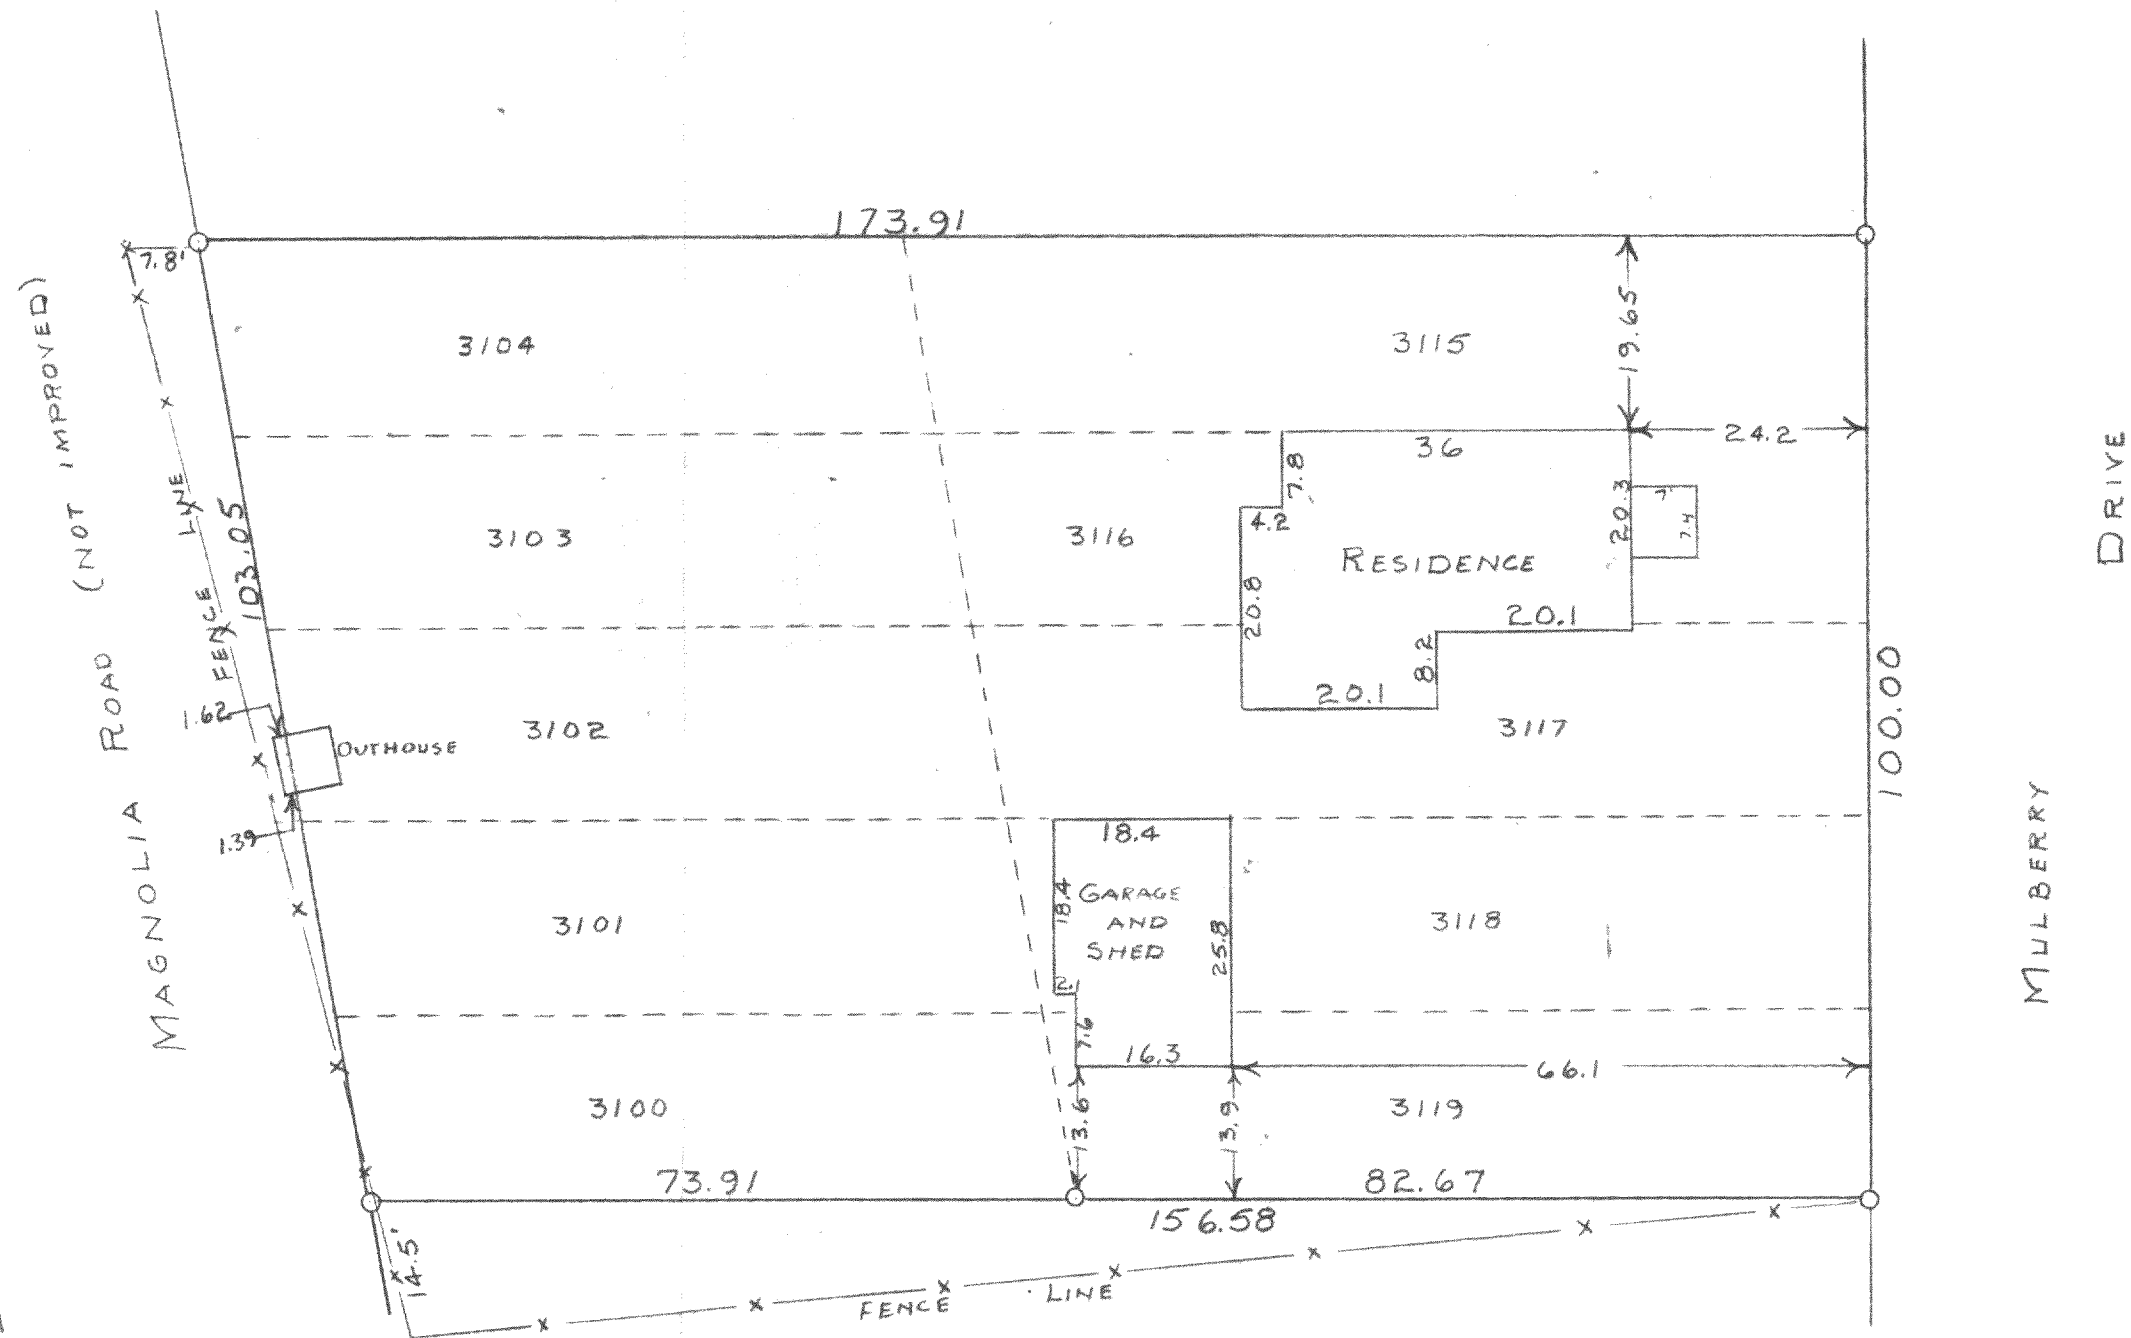


STATE OF WISCONSIN)
 WALWORTH COUNTY) ss

I, GEORGE T. DUNHAM, DO HEREBY CERTIFY THAT I HAVE SURVEYED THE
 PROPERTY DESCRIBED AS FOLLOWS:

LOTS 3100-3104 INCLUSIVE AND LOTS 3115-3119 INCLUSIVE OF
 SECTION 2, PELL LAKE SUBDIVISIONS LOCATED IN THE TOWN OF
 BLOOMFIELD, WALWORTH COUNTY, WISCONSIN.

AND THAT THE PLAT SHOWN ABOVE IS A CORRECT REPRESENTATION OF THE
 PROPERTY LINES AND OF THE IMPROVEMENTS LOCATED THEREON
 NOV. 6, 1958

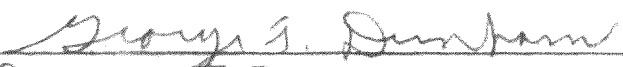
 GEORGE T. DUNHAM, SURVEYOR
 DELAWARE, WISCONSIN

118-45