

PLAT OF SURVEY

LOTS 48 & 49, BLOCK 1, OF THE 8TH ADDITION TO SHINNER'S NIPPERSINK PARK, A SUBDIVISION OF PART OF SECTION 24, T. 1 N., R. 18 E. OF THE 4TH P.M., TOWNSHIP OF BLOOMFIELD, COUNTY OF WALWORTH, STATE OF WISCONSIN.

SCALE 1" = 20'

o = IRON PIPE STAKE FOUND OR SET AS NOTED ON PLAT



FOR: ROBERT MICHELS.

I have surveyed the above described property and the map hereon is a true and correct representation and shows the size and location of the property, its exterior boundaries, the location and dimensions of all visible structures thereon, fences, apparent easements, and all other visible encumbrances.

This survey is made for the use of the present owners of the property and who those who purchase, mortgage, or otherwise transfer the title thereto, within one year from date hereof, and as to them I warrant the accuracy of said survey and map.

Dated at Burlington, Wis. 8th day of AUGUST 1974

John F. Degen
John F. Degen, Land Surveyor No. 126

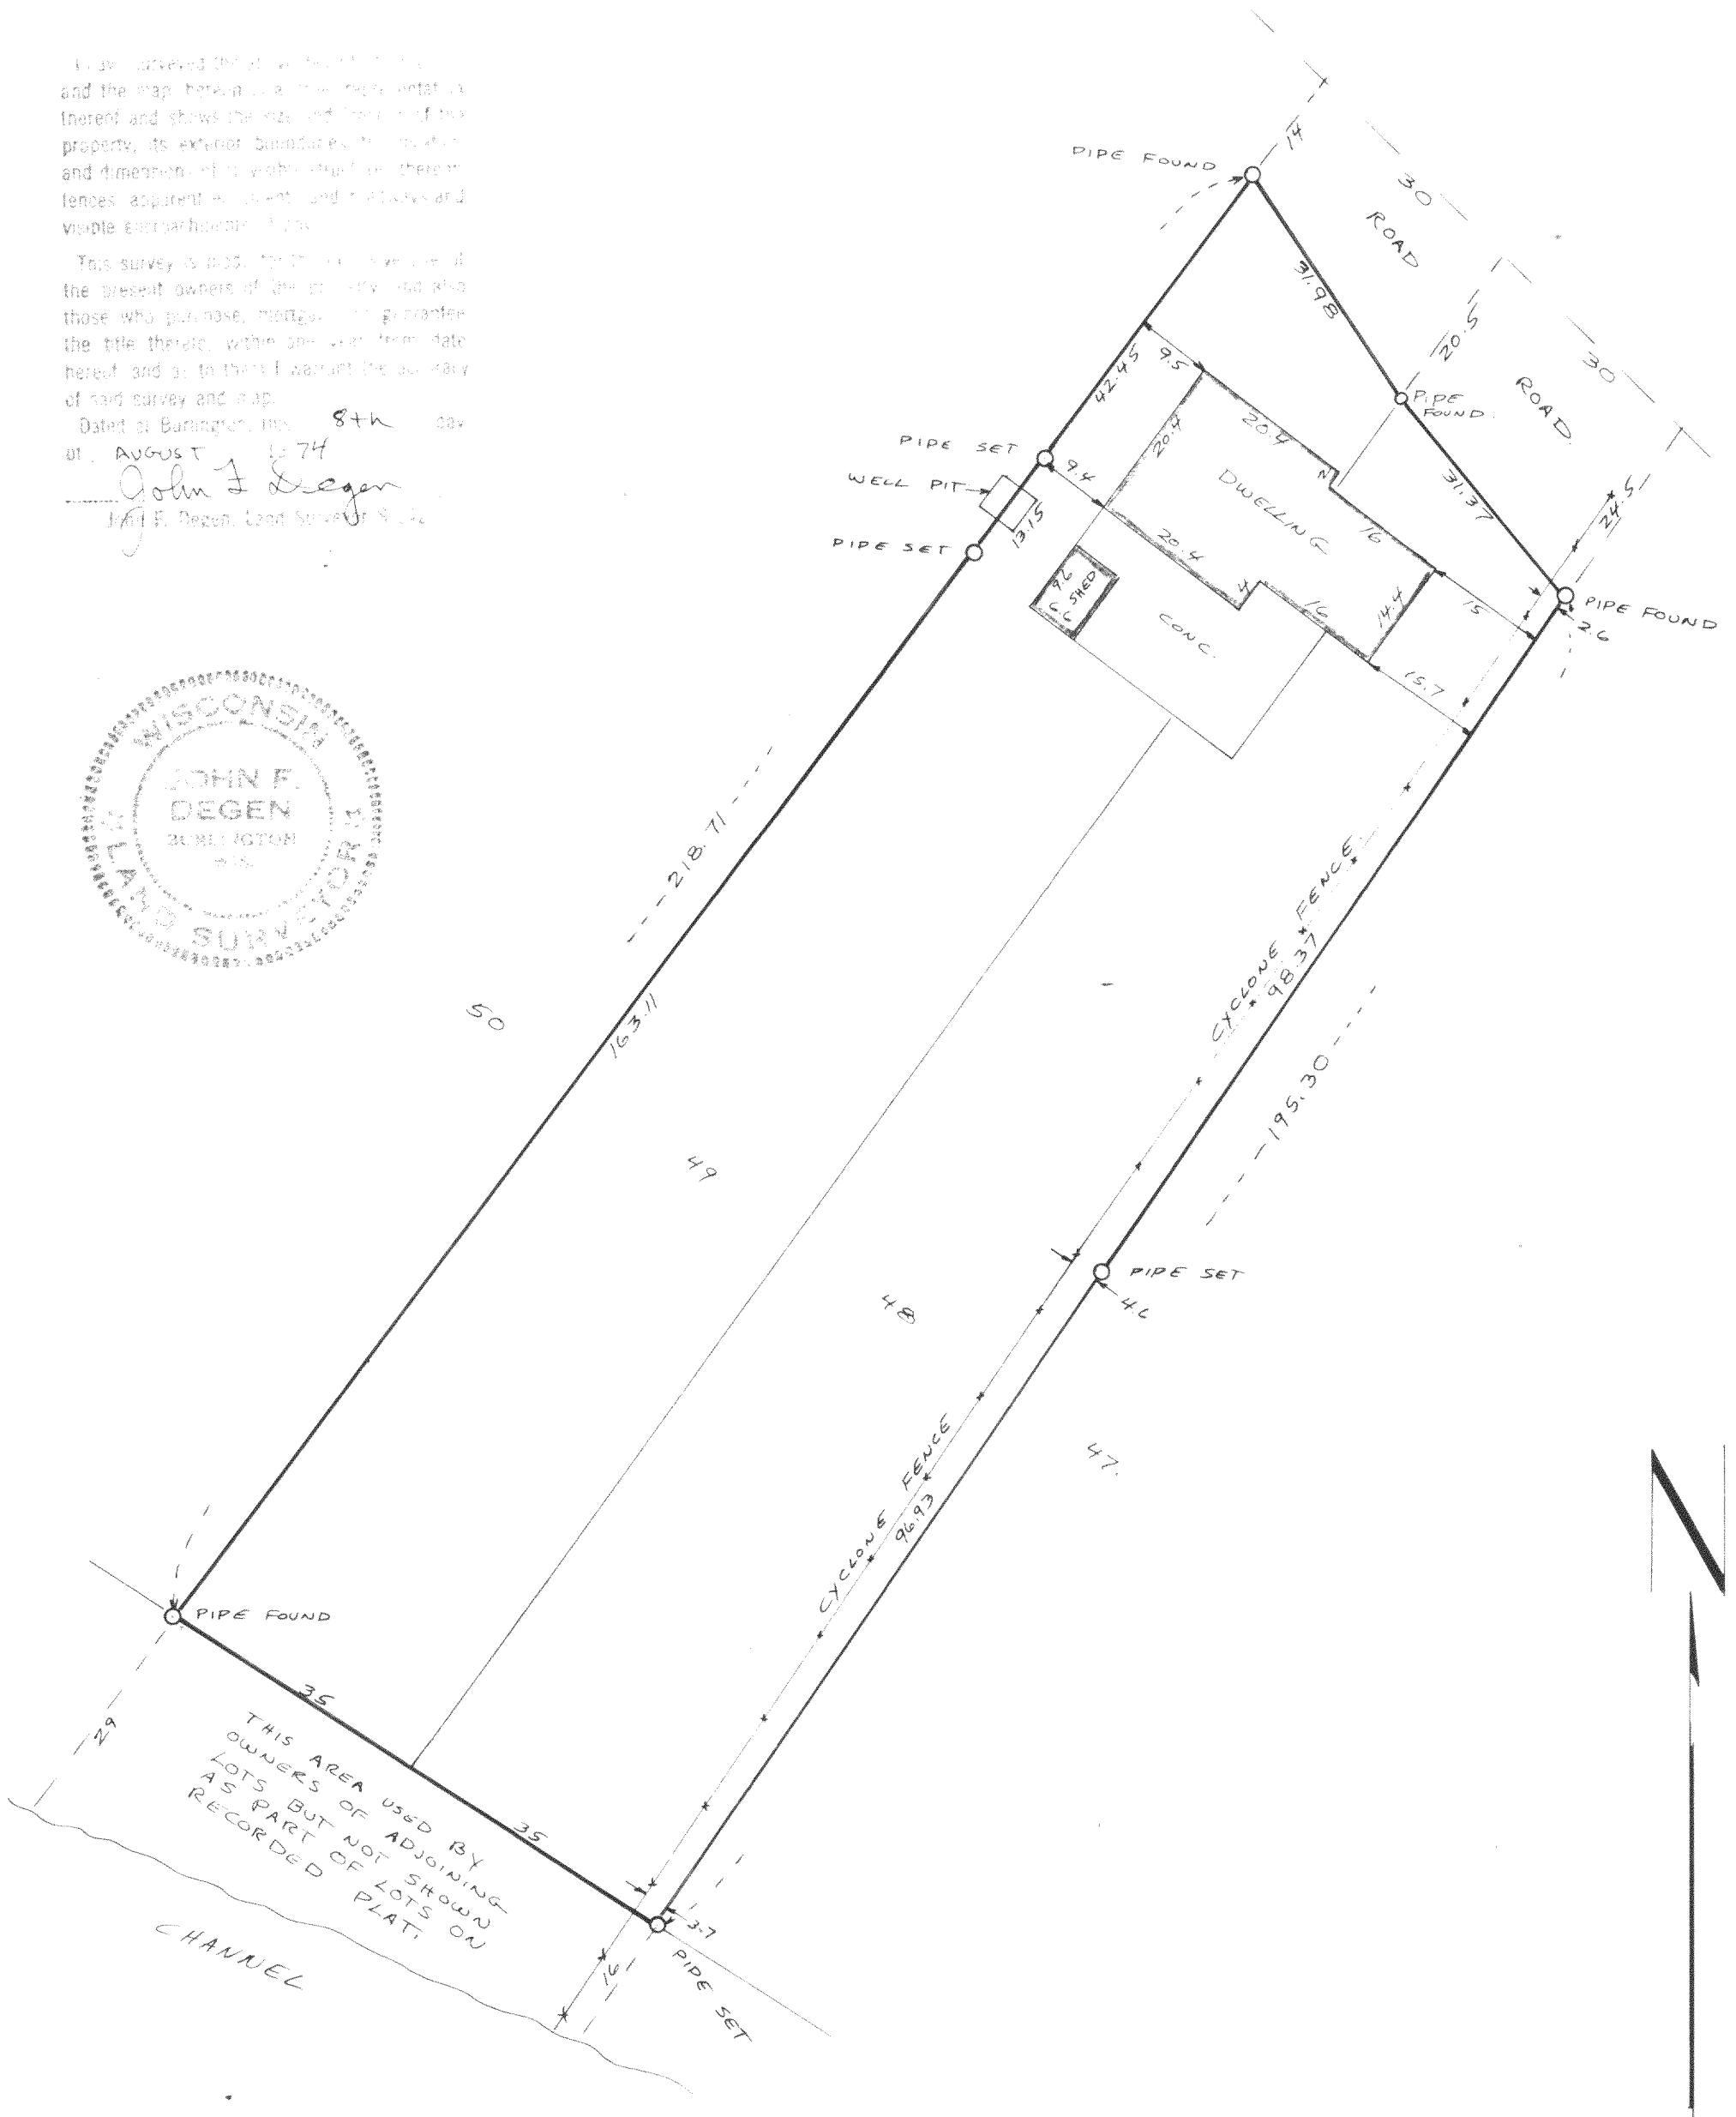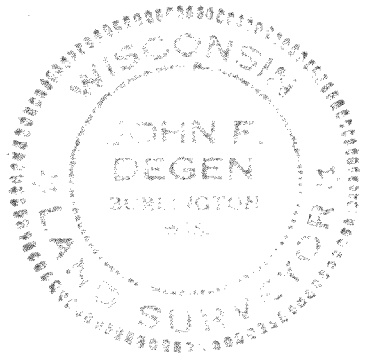

THIS AREA USED BY OWNERS OF ADJOINING LOTS BUT NOT SHOWN AS PART OF LOTS ON RECORDED PLAT.