


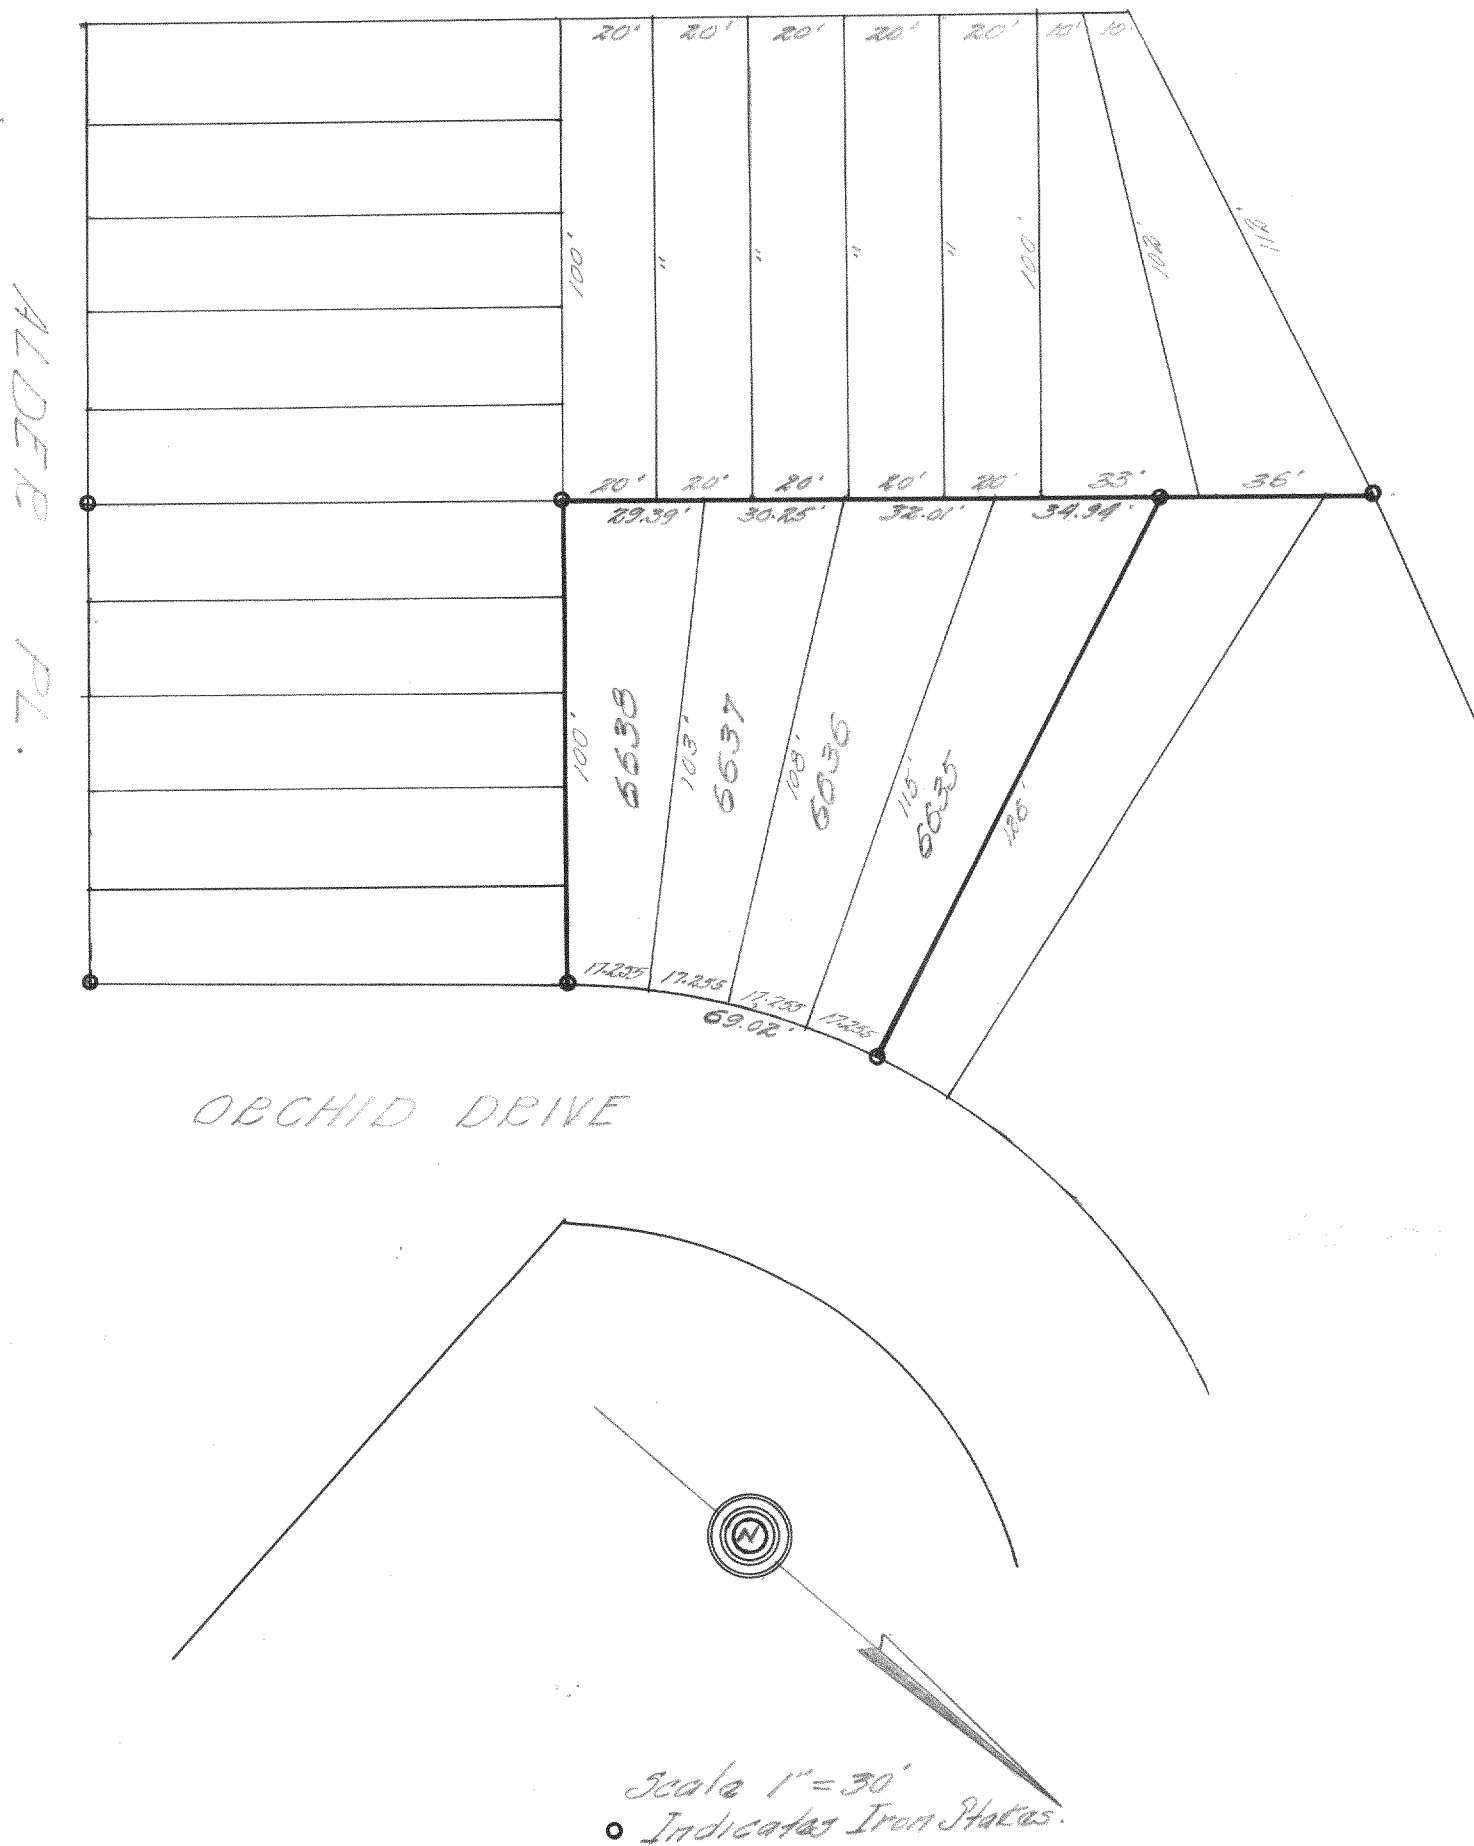

DESCRIPTION:

Lots 6635, 6636, 6637 and 6638 of Pell Lake Subdivision of a portion of Bloomfield Township, Walworth County, Wisconsin.

CERTIFICATE:

I, hereby certify that I, have on this the 26th day of July 1945, surveyed the above described property according to the official records on file in the Office of the Recorder of Deeds in and for Walworth County, Wisconsin, and find that no encroachments exist and that the plat hereon portrayed is an exact reproduction of the conditions found at the site on this day.

SIGNED AND SEALED THIS 30th DAY OF JULY 1945.

Joseph M. Biagi.
 Joseph M. Biagi.
 Professional Engineer
 Elkhorn Wisconsin.