

PLAT OF SURVEY
OF

LOTS 1 & 3, LAKE GROVE SUBDIVISION, LOCATED IN THE SOUTHEAST 1/4 OF SECTION 13, T. 1 N.,
R. 18 E. OF THE 4TH P.M., TOWNSHIP OF BLOOMFIELD, COUNTY OF WALWORTH, STATE OF WISCONSIN.

I HEREBY CERTIFY THAT I HAVE SURVEYED THE LAND DESCRIBED ABOVE AND THAT THE PLAT DRAWN
HEREON IS A CORRECT REPRESENTATION OF SAID SURVEY.

John F. Degen 6-20-75
JOHN F. DEGEN, LAND SURVEYOR #242
589 N. PINE ST., BURLINGTON, WISCONSIN.

SCALE 1" = 30'

FOR: ANTHONY LAS

o = IRON PIPE STAKE UNLESS
OTHERWISE NOTED.

BEARING ARE THOSE OF
RECORDED PLAT.

E = ELEVATION RELATIVE TO
POWER LAKE LEVEL. LAKE


LOT 5 LEVEL ON 6-20-75
was E 50.00 ASSUMED.

BLK 2 LOTS 1 AND 3 ARE
VACANT.

JEFFERSON
ISLAND

SHED

LOT

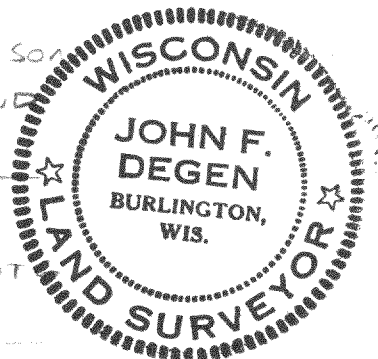

NOTE: RECORDED PLAT OF
LAKE GROVE SUBDIVISION CALLS
FOR LOT 1 TO BE 105.6 FEET
FROM CENTER LINE OF ROAD.
LOT IS SUBJECT TO RIGHTS OF
PUBLIC FOR HIGHWAY.

