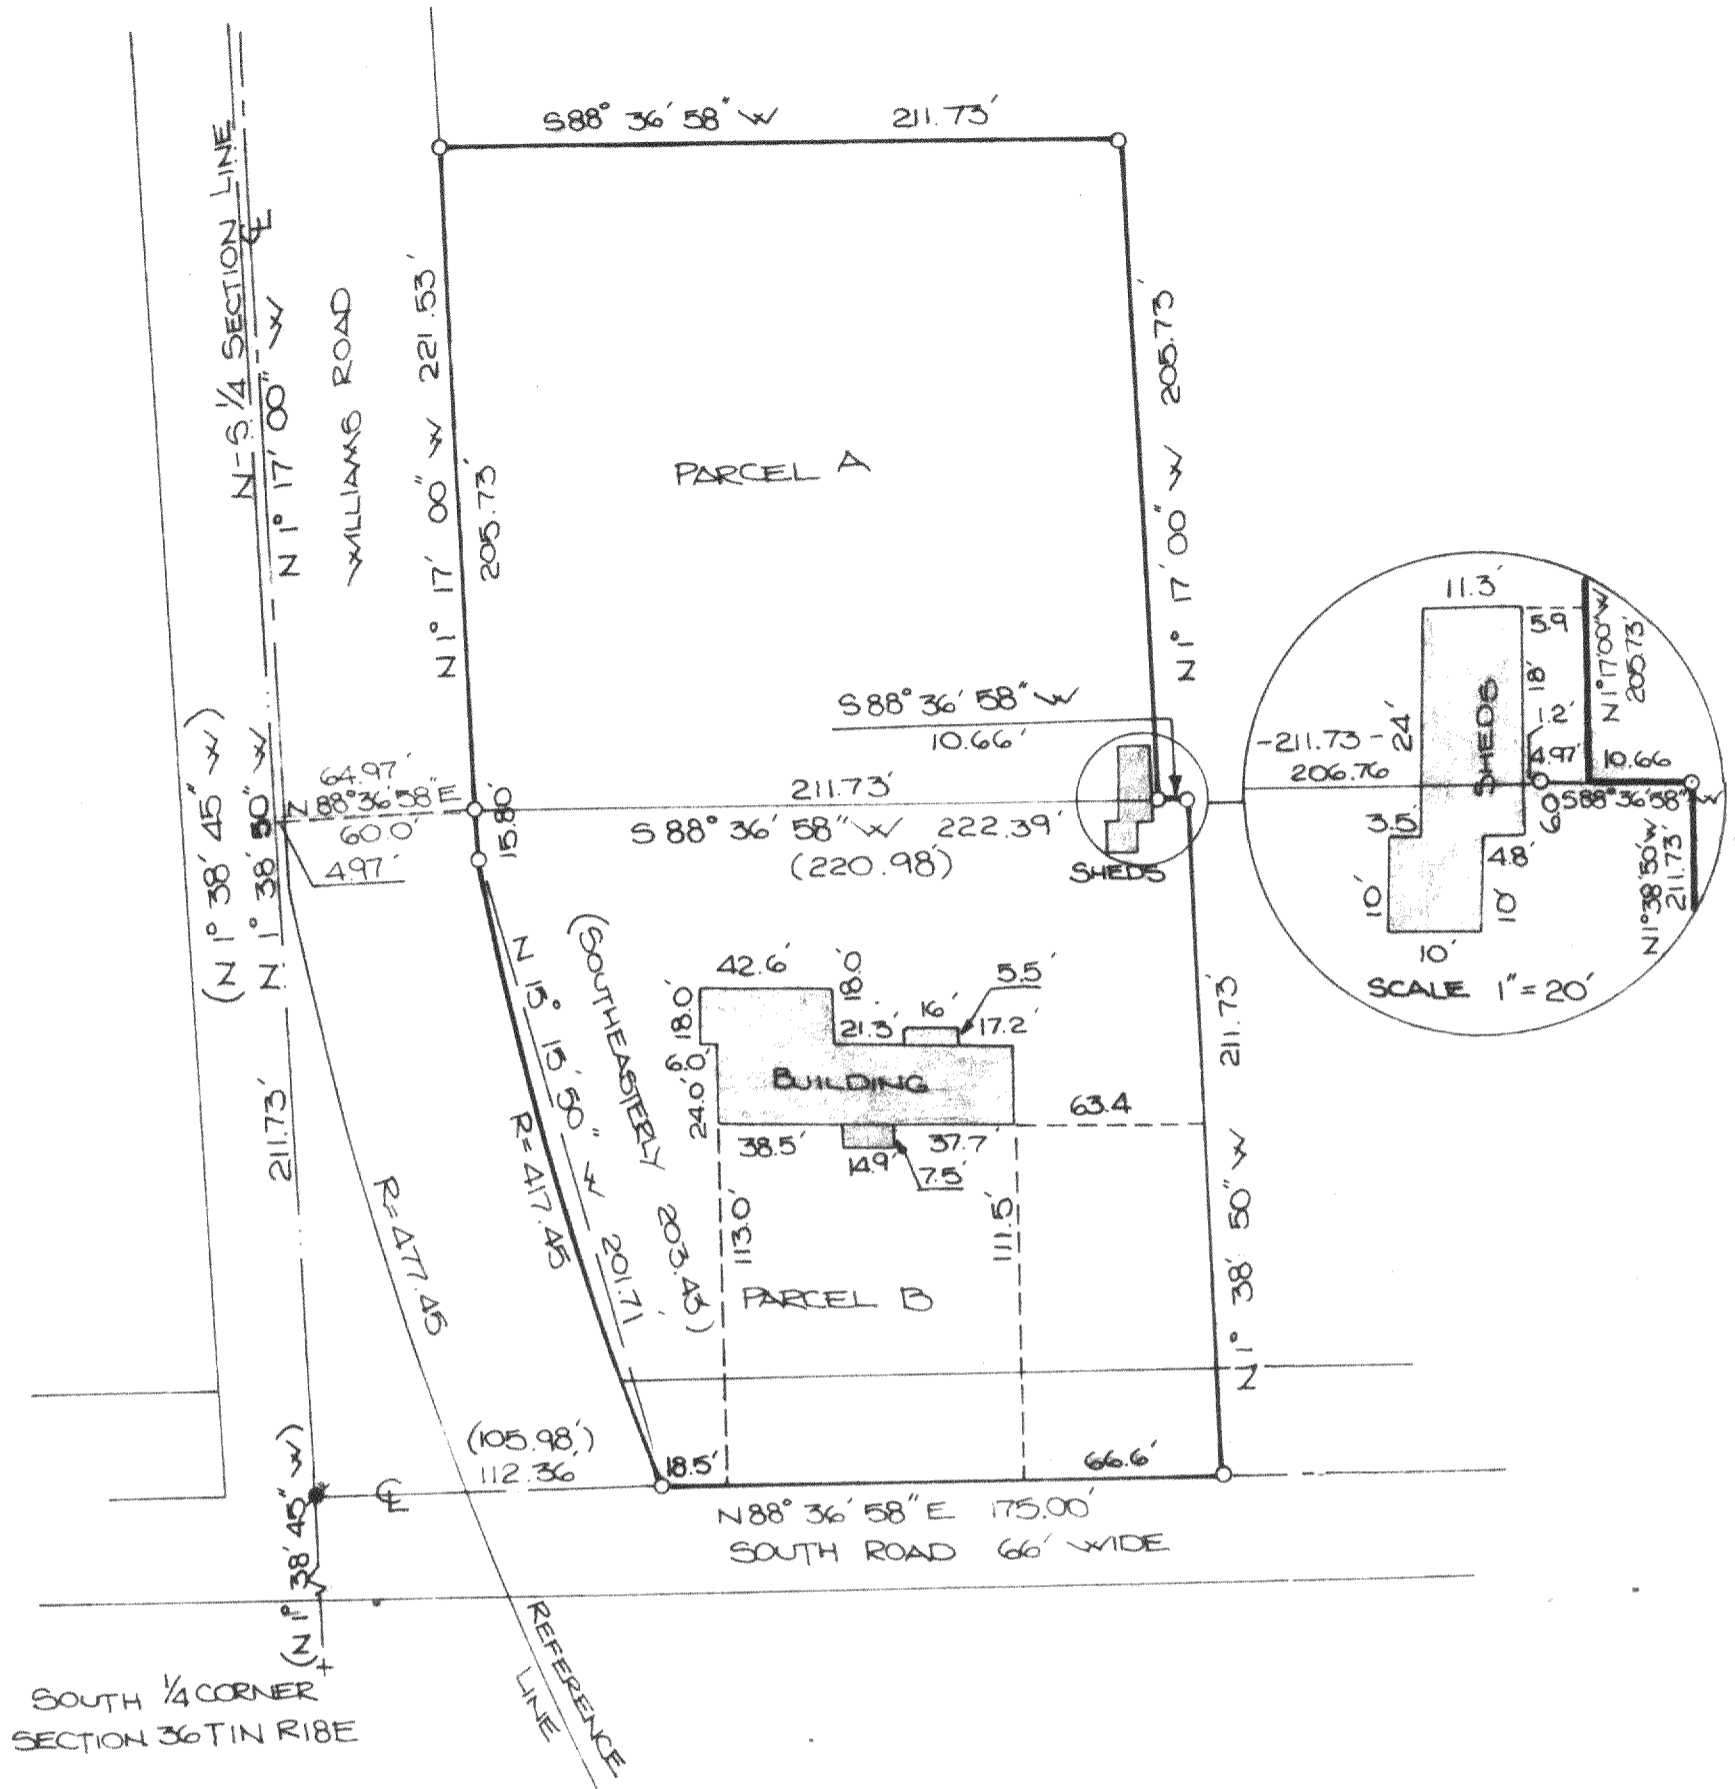


**HAROLD H. KOLB**REGISTERED PROFESSIONAL LAND SURVEYOR  
LAKE GENEVA, WISCONSIN

B-36-3C

118-556