


HAROLD H. KOLB

REGISTERED PROFESSIONAL LAND SURVEYOR
LAKE GENEVA, WISCONSIN

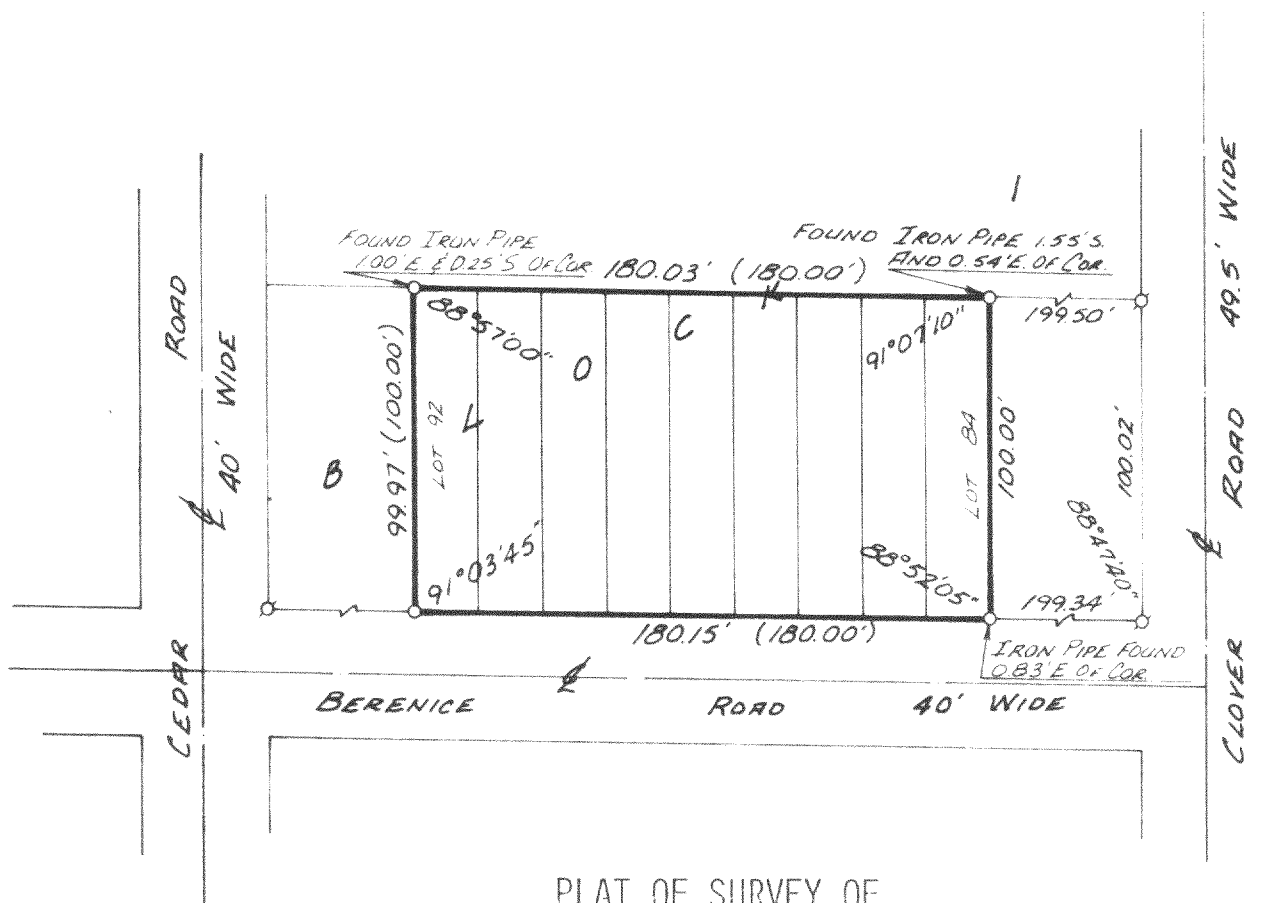


PLAT OF SURVEY OF

LOTS 84 92, BLOCK 2, PELL LAKE
HIGHLANDS, T1N, R18E, WALWORTH
COUNTY, WISCONSIN.

OWNER: IWAN ODARCZENKO

ACCURACY: DISTANCES $\pm 0.01'$
ANGLES $\pm 05''$

ERROR OF CLOSURE - LESS THAN
ONE PART IN 3000

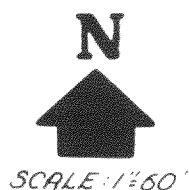

LEGEND

- O — IRON PIPE PLACED.
- — CONCRETE MONUMENT
- ⊙ — IRON PIPE FOUND

WITNESSES: I, the undersigned, being duly sworn, depose and say that I am a duly qualified and licensed Professional Land Surveyor in the State of Wisconsin, and that I am the owner of the above described land, and that I am the owner of the above described land, and that I am the owner of the above described land.

Harold H. Kolb
HAROLD H. KOLB
WISCONSIN REGISTERED LAND SURVEYOR, S-187
DATE March 29, 1977

118-558