


WHITEWATER, WISCONSIN 53190


CLOVER ROAD 49.5' WIDE

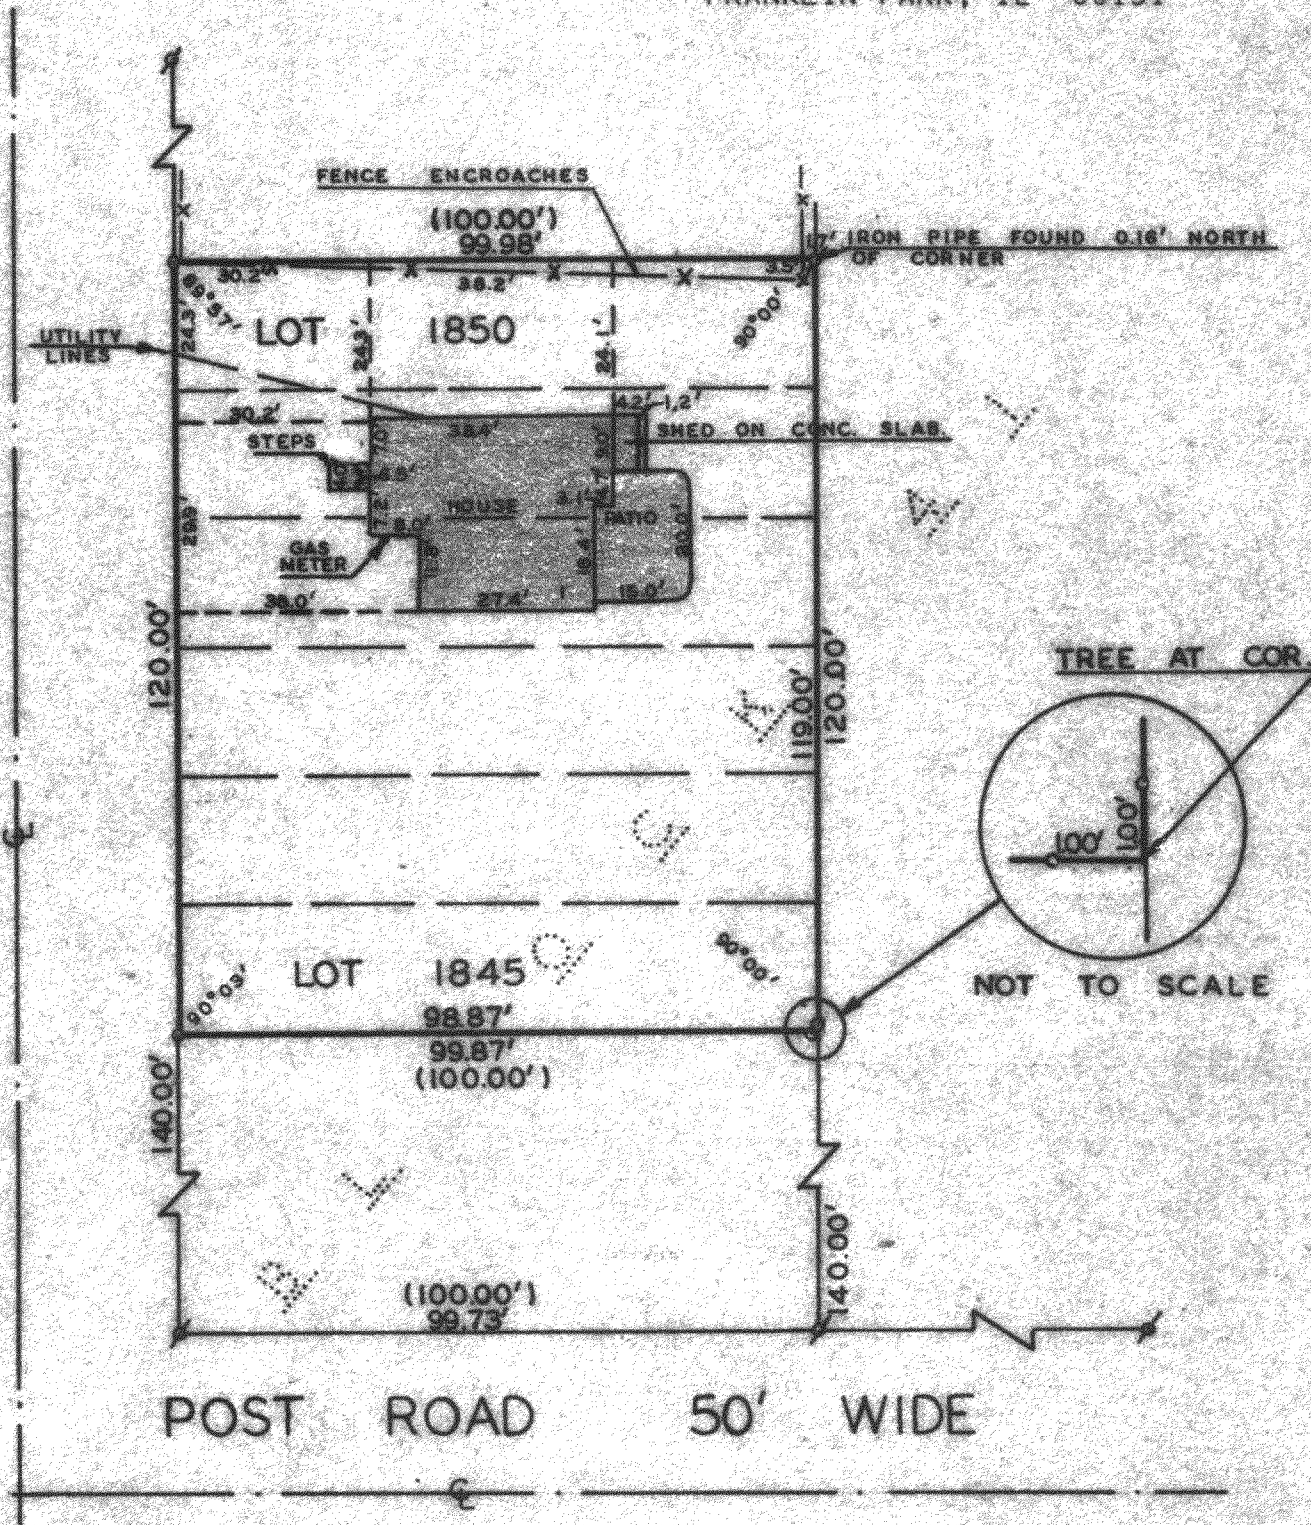

LOTS 1845-1850, BLOCK 41, PELL LAKE SUB-DIVISION, WALWORTH COUNTY, WISCONSIN.

THIS SURVEY IS MADE FOR THE USE OF THE PRESENT OWNERS OF THE PROPERTY AND ALSO THOSE WHO PURCHASE, MORTGAGE, OR GUARANTEE THE TITLE THERETO WITHIN ONE (1) YEAR FROM DATE HEREOF.

HAROLD H. KOLB
WISCONSIN REGISTERED LAND SURVEYOR, S- 187
DATE July 11, 1979

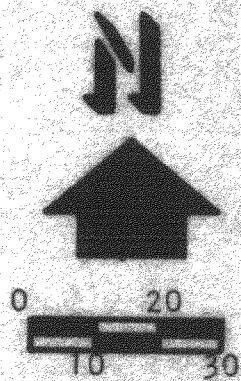

SCALE IN FEET

LEGEND:

- - IRON PIPE FOUND
- - IRON PIPE PLACED
- Y - FENCE
- () - AS PLATTED

