


KOLB LAND CONSULTING, INC.
LAND SURVEYING • SUBDIVIDING • LAND PLANNING

LAKE GENEVA, WISCONSIN 53147


WHITEWATER, WISCONSIN 53190

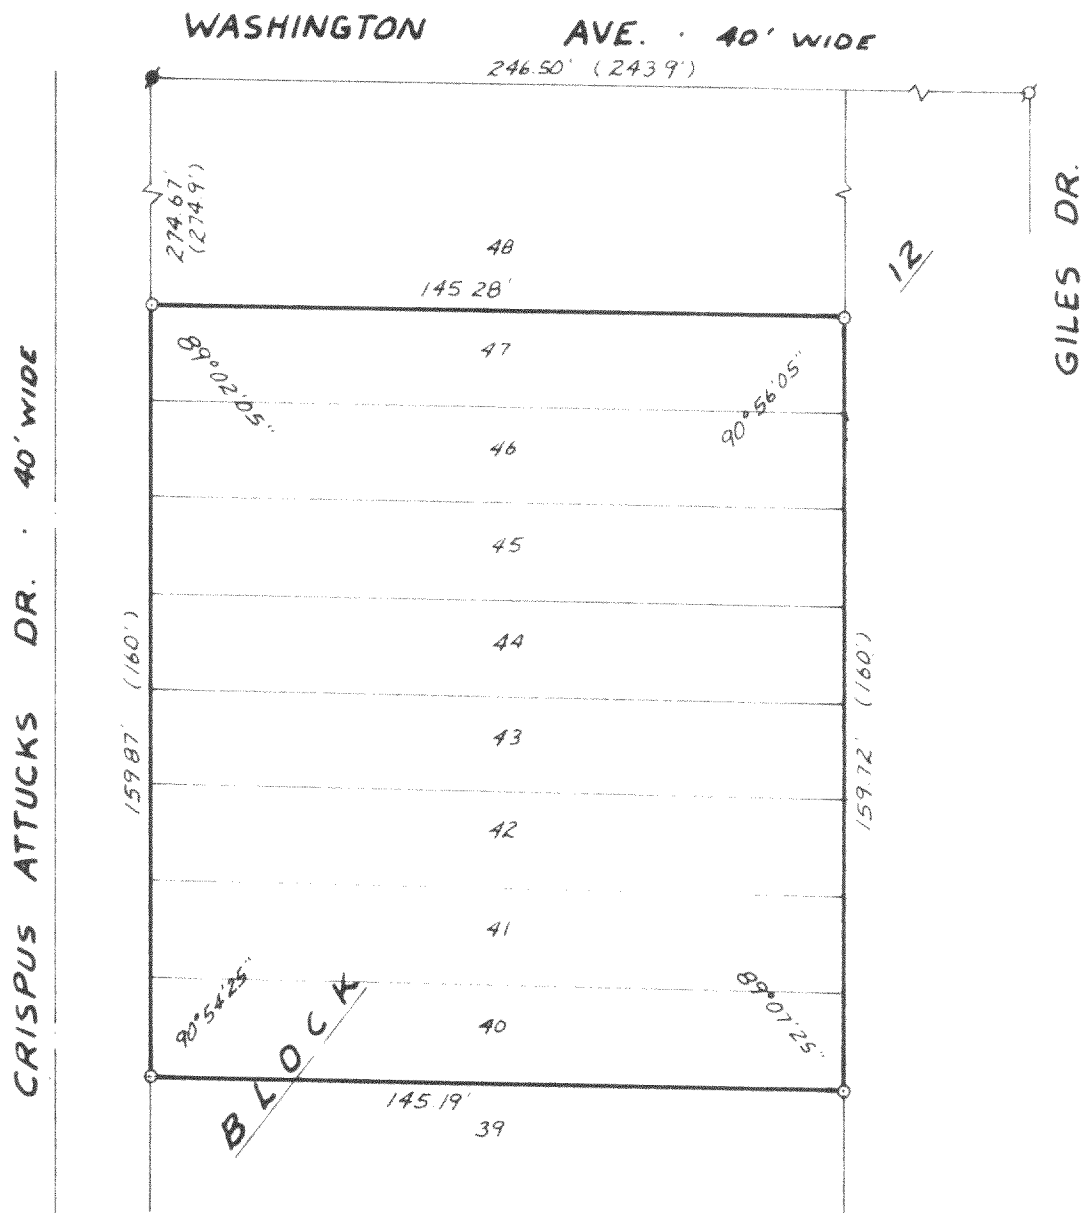

PLAT OF SURVEY OF

LOTS 40-47, BLOCK 12, LAKE IVANHOE RESORT,
TOWN 1 NORTH, RANGE 18 EAST, WALWORTH COUNTY,
WISCONSIN.

OWNER: MS. CHARLIE GILMER
45 W. 148TH ST.
HARVEY, ILLINOIS 60426

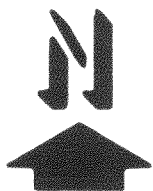

Scale 1" = 40'

LEGEND

- - IRON ROD FOUND
- σ - IRON PIPE FOUND
- () - RECORDED AS
- o - IRON PIPE SET

I, HAROLD H. KOLB, DO HEREBY CERTIFY
THAT I HAVE SURVEYED THE PROPERTY
HEREON DESCRIBED ACCORDING TO THE
OFFICIAL RECORDS, AND THAT THE PLAT
HEREON IS A CORRECT REPRESENTATION
OF THE LOT LINES TO THE BEST OF MY
KNOWLEDGE AND BELIEF.

Harold H. Kolb

HAROLD H. KOLB
WISCONSIN REGISTERED LAND SURVEYOR, S-187

DATE Sept. 24, 1981