


ENGINEERING, SURVEYING AND LAND PLANNING
715 W. WALWORTH ST. - P.O. BOX 487 - ELKHORN, WI 53121
OFFICE: 414/723-2098

HONEYSUCKLE 40 WIDE ROAD

OVERHEAD POWER SERVICE TO
NEIGHBOR ENCLOSES 2'±

CAUTION: FOUND SEVERAL PIPES
PLACED BY PROPERTY OWNER

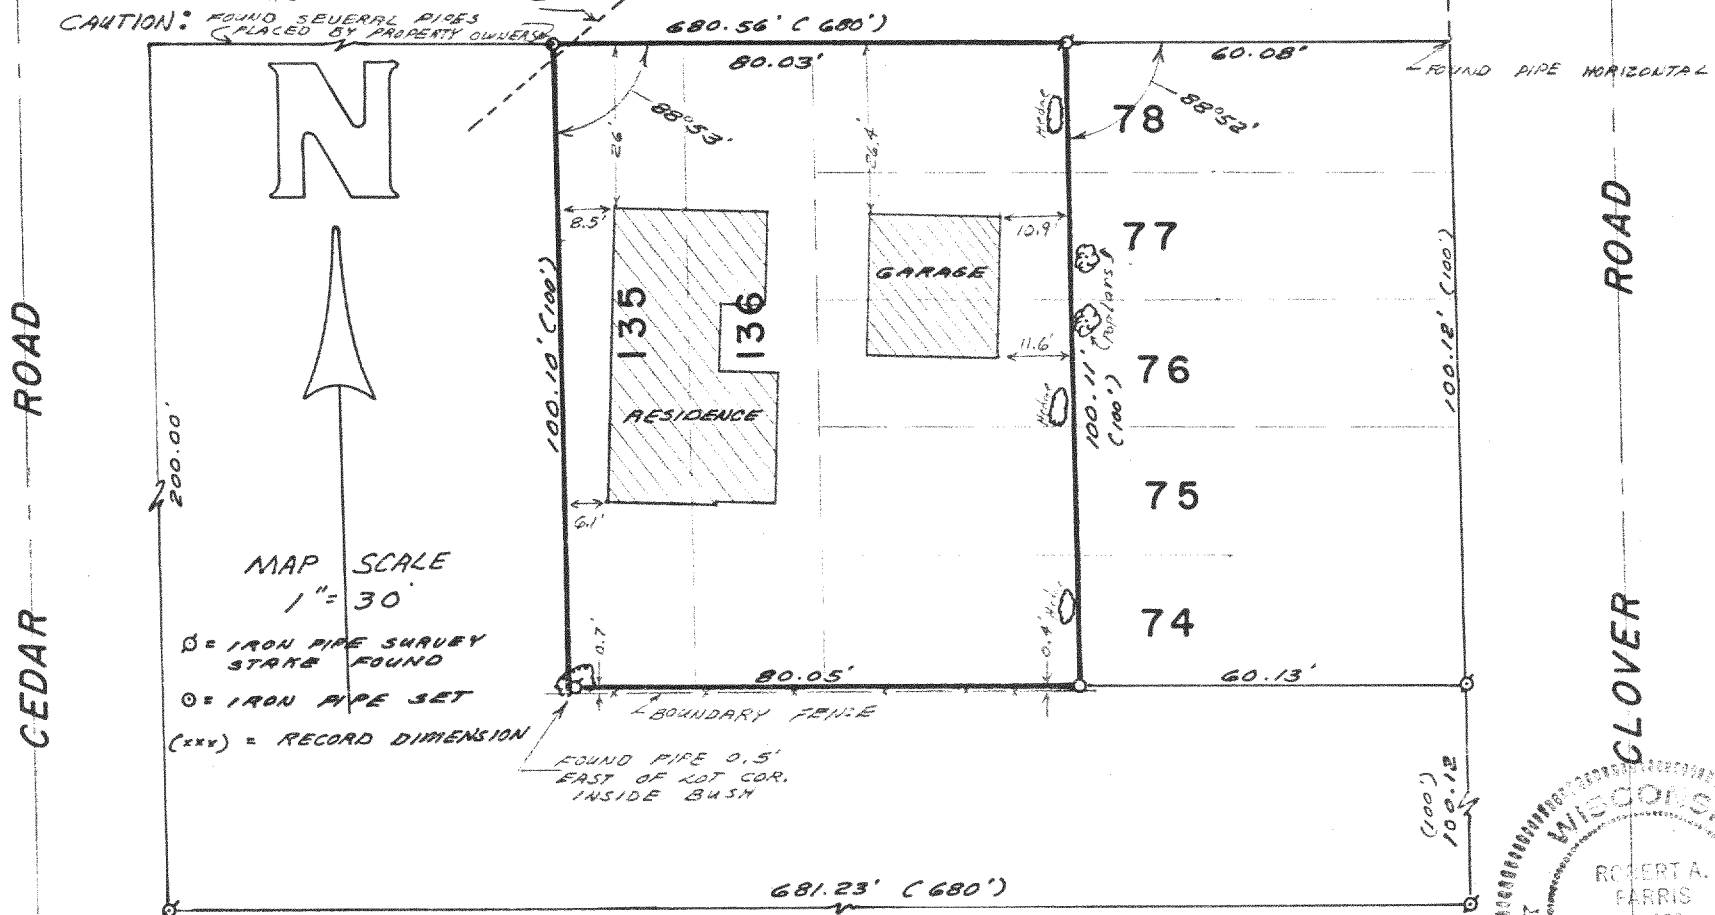

I HEREBY CERTIFY that I have surveyed the property hereon described and that this Plat of Survey is a true and accurate representation of the boundary and the structures located thereon to the best of my professional knowledge and belief.

Dated this 28th day of October, 1980

Robert A. Harris

DRAWING NUMBER 1774

118-610-F^v