


FARRIS, HANSEN & COOPER, INC.

ENGINEERING, SURVEYING AND LAND PLANNING
715 W. WALWORTH ST. - P.O. BOX 467 - ELKHORN, WI 53121

WORK ORDERED BY:
HELEN NORGAARD
BOX 92
PELL LAKE, WI 53157

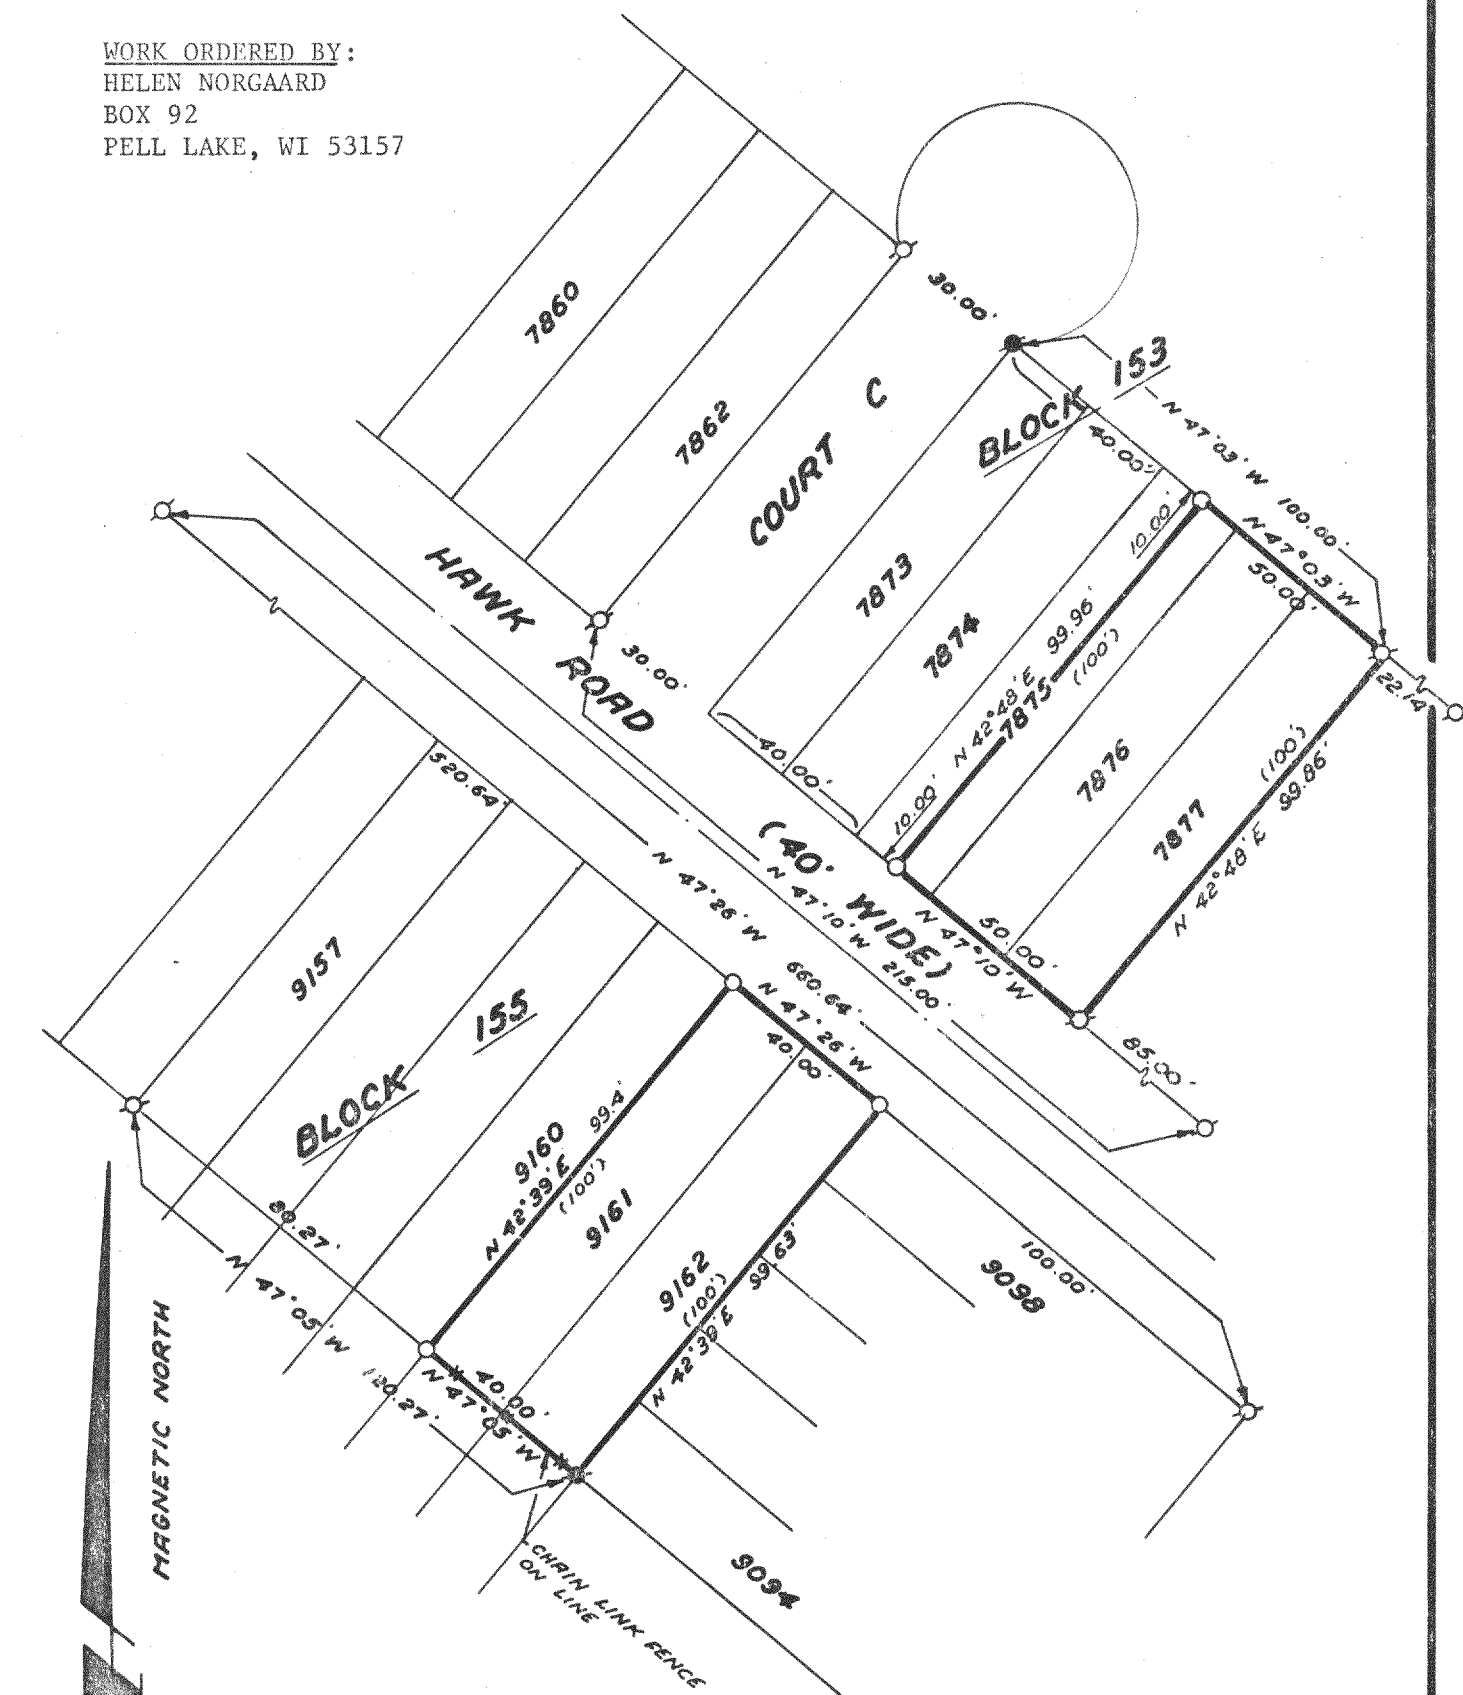


PLAT OF SURVEY OF

LOTS 9161 AND 9162, BLOCK 155 AND
LOTS 7877, 7876, AND 1/2 OF 7875, BLOCK 153,
SECTION "5" OF PELL LAKE SUBDIVISION, TOWN OF
BLOOMFIELD, WALWORTH COUNTY, WISCONSIN.

LEGEND

- FOUND 3/8" SQ IRON ROD
SURVEY STAKE
- FOUND IRON PIPE SURVEY
STAKE
- SET IRON PIPE SURVEY
STAKE
- () = RECORD DIMENSION

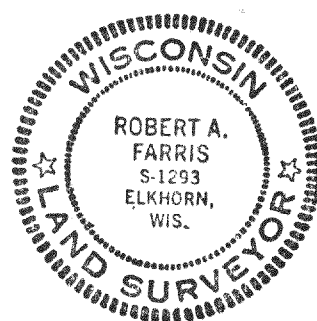

I HEREBY CERTIFY that I have surveyed the property described hereon and that this Plat of Survey is a true and accurate representation of the lot lines to the best of my professional knowledge and belief.

Robert A. Farris

Robert A. Farris, RLS No. 1293.

Dated this 26th day of August, 1980.

Revised this 18 day of AUGUST, 1980. PROJECT NO. 1731

118-611-F