


FARRIS, HANSEN & COOPER, INC.

ENGINEERING, SURVEYING AND LAND PLANNING
715 W. WALWORTH ST. - P.O. BOX 487 - ELKHORN, WI 53121

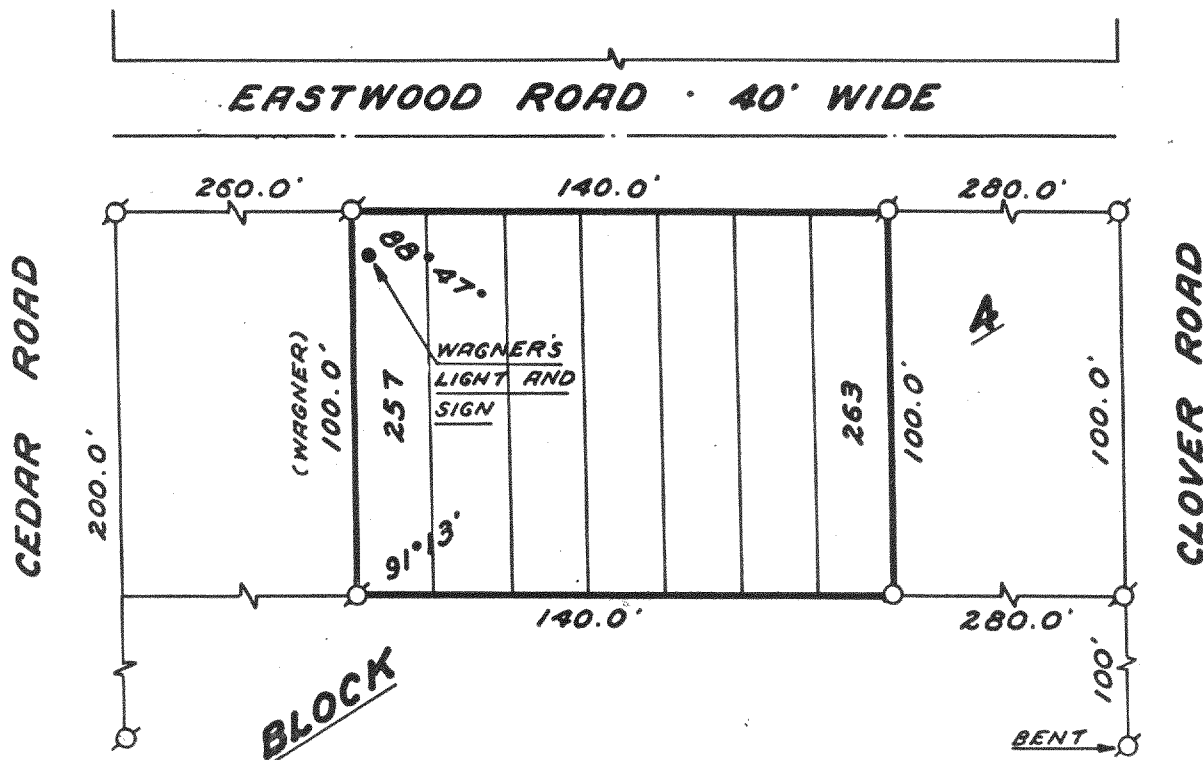

PLAT OF SURVEY OF

Lots 257-263, Block 4, Pell Lake Highlands, Town
1 North, Range 18 East, Town of Bloomfield, Walworth
County, Wisconsin.

ORDERED BY: Jan Spencer
Bay Realty

OWNER: Albert Herrmann

BUYER: Boguslaw Zlotek

LEGEND

⊙—Iron Pipe Found

○—1" x 24" Iron
Pipe Set

I HEREBY CERTIFY that I have
surveyed the property described
hereon and that this Plat of
Survey is a true and accurate
representation of the lot lines
to the best of my professional
knowledge and belief.

Robert A. Farris
Robert A. Farris, RLS No. 1293

Dated this 26 day of July 1979.

0 10 20 30 40 50



SCALE IN FEET
1" = 50'



PROJ. NO. 1563

118-615F