

PLAT OF SURVEY
OF

LOTS 12 & 13, BLOCK 1, OF THE 8TH ADDITION TO NIPPERSINK PARK, A SUBDIVISION OF PART OF SECTION 24, T. 1 N.
R. 18 E. OF THE 4TH P.M., TOWNSHIP OF BLOOMFIELD, COUNTY OF WALWORTH, STATE OF WISCONSIN.

FOR: BUEHN REALTY

SCALE 1" = 40'

o = IRON PIPE STAKE FOUND

BEARINGS ARE RELATIVE TO THE PUBLIC ROAD WHICH
WAS PLATTED AS N. 30°44' W.


o = PIPE SET



I have surveyed the above-described prop-
erty and the map hereon is a true representa-
tion thereof and shows the size and location of
property, its exterior boundaries, the local-
ity and dimensions of all visible structures there-
on, fences, apparent easements and roadway, and
visible encroachments, if any.

This survey is made for the exclusive use of
the present owners of the property, and also
those who purchase, mortgage, or guarantee
the title thereto, within one year from date
hereof.

Dated at Burlington, this 6th day
of AUGUST 1975
John F. Degen
John F. Degen, Land Surveyor S 242
RE-SURVEYED 8-4-80

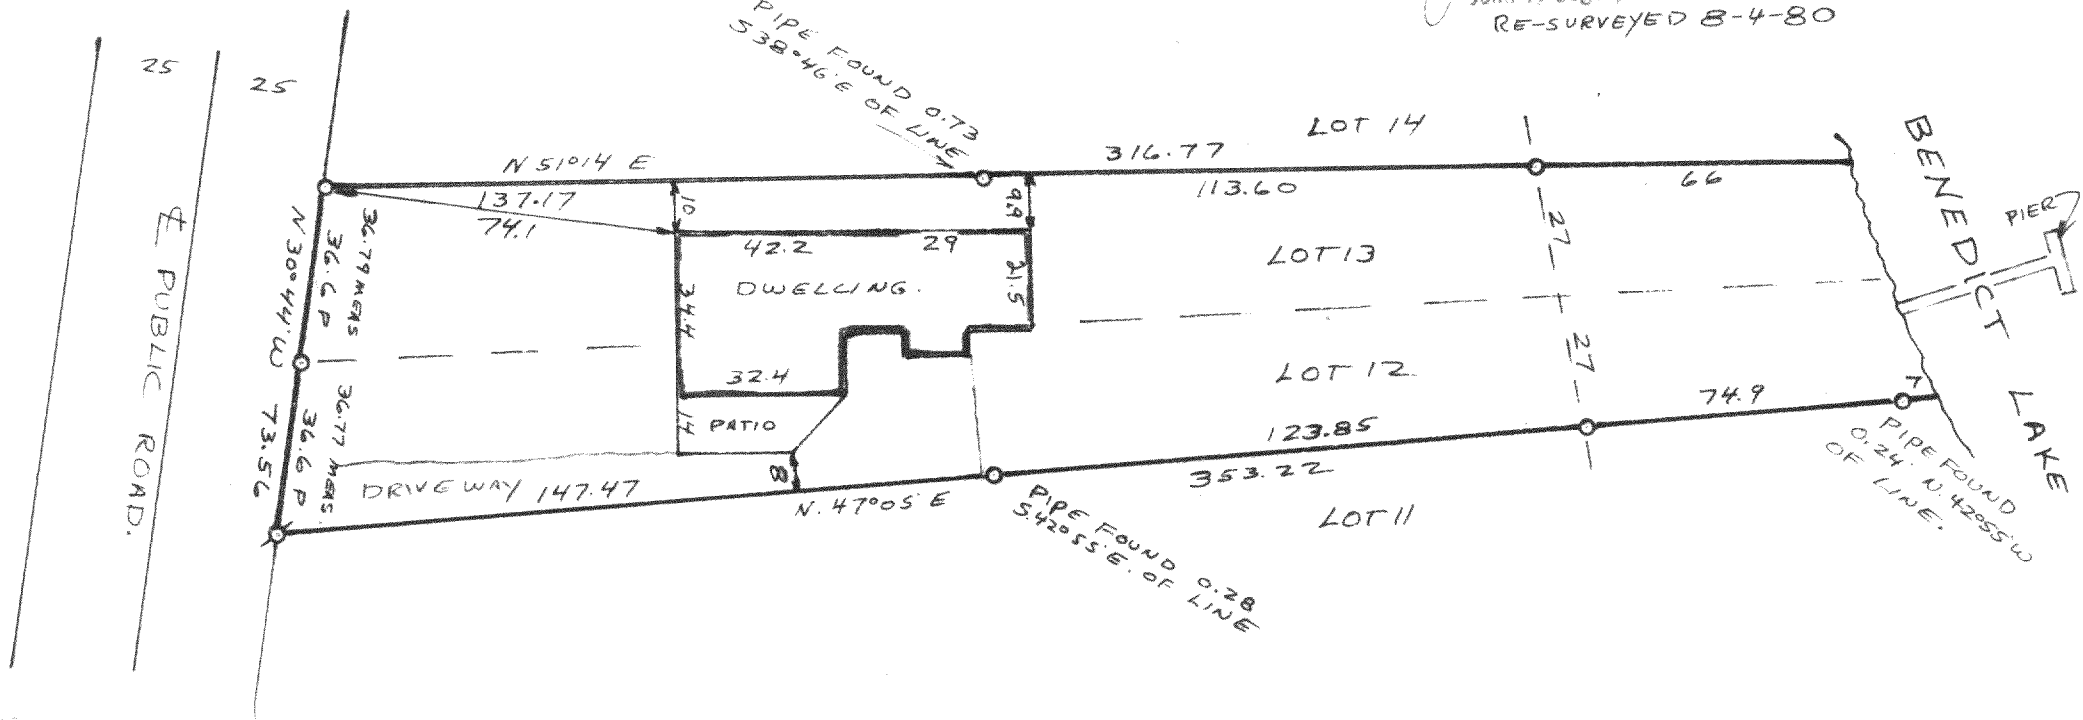

20
MNPS8-75

118-629 D JFD 8-8-75 DRAWER 6-0-3 10