


KOLB LAND CONSULTING, INC.
LAND SURVEYING • SUBDIVIDING • LAND PLANNING

LAKE GENEVA, WISCONSIN 53147


WHITEWATER, WISCONSIN 53190

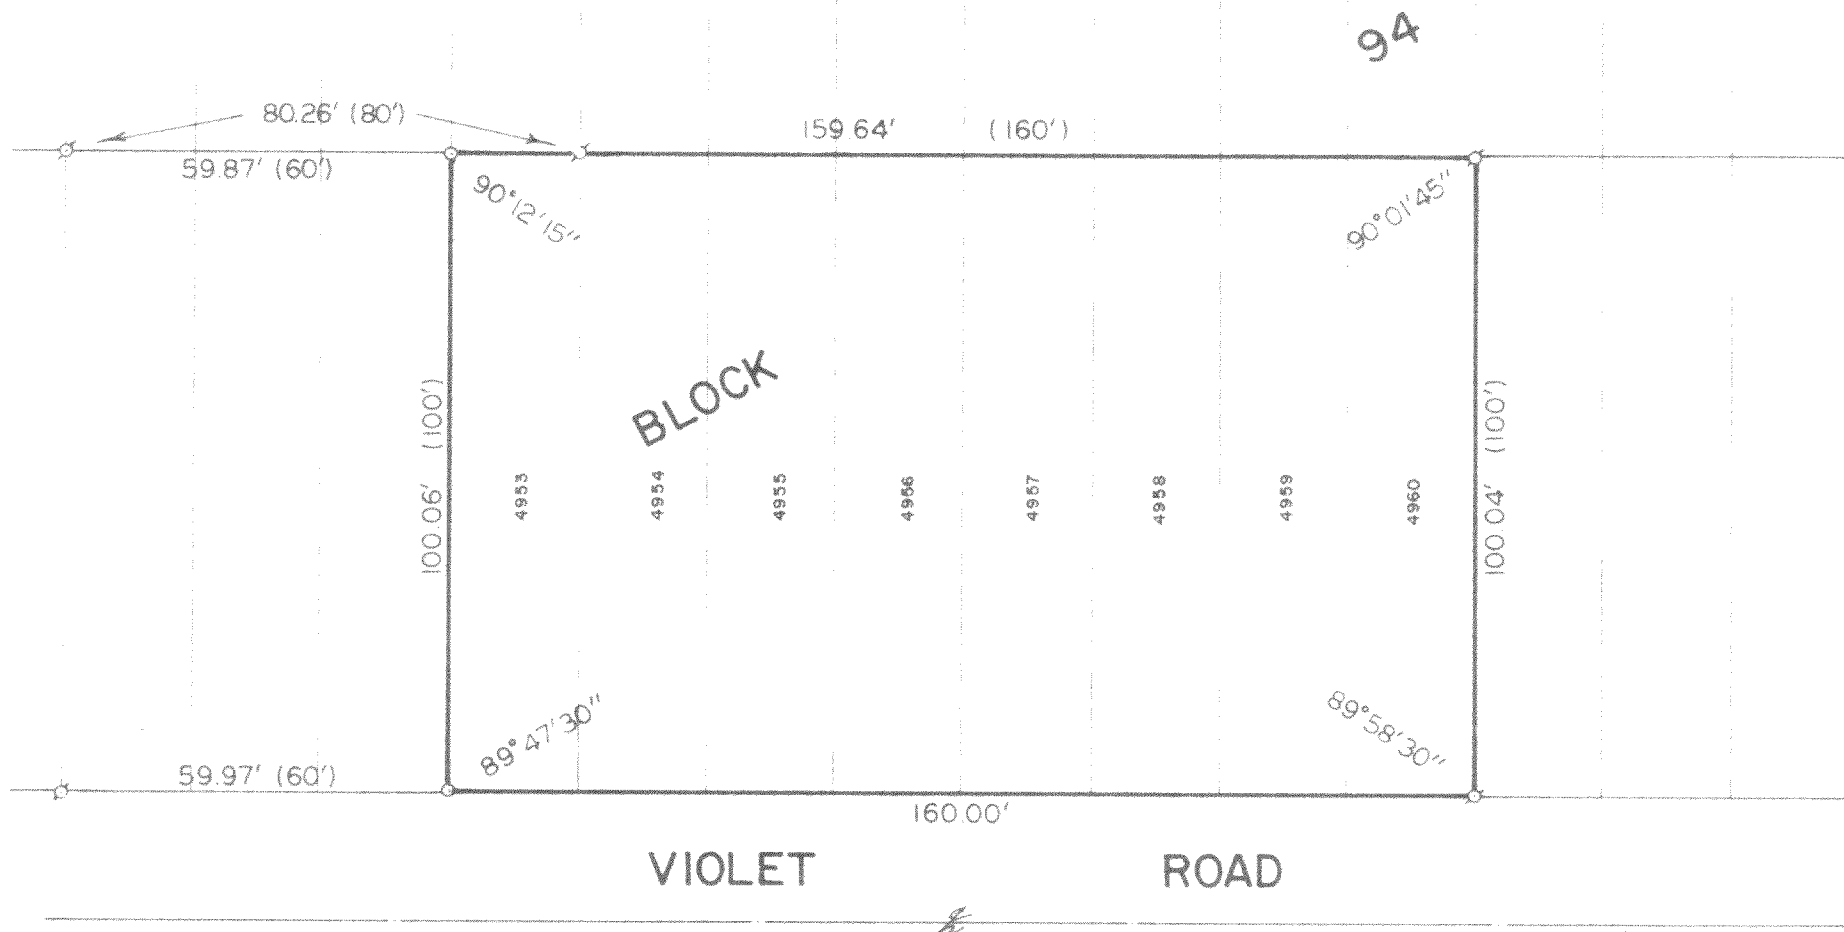

PLAT OF SURVEY OF


LOTS 4953-4960, BLOCK 94, PELL LAKE SUBDIVISION,
LOCATED IN T 1 N, R 18 E, WALWORTH COUNTY,
WISCONSIN.

ORDERED BY: ROBERT MUNGER
C/O EMIL BERMAN
BOX 527
PELL LAKE, WISCONSIN 53157

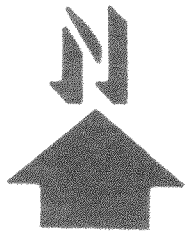

SCALE: 1"=30'

⌘ - IRON PIPE FOUND
○ - IRON PIPE PLACED
() - RECORDED AS

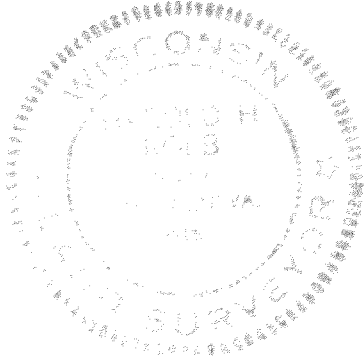

I, HAROLD H. KOLB, DO HEREBY CERTIFY
THAT I HAVE SURVEYED THE PROPERTY
HEREON DESCRIBED ACCORDING TO THE
OFFICIAL RECORDS, AND THAT THE PLAT
HEREON IS A CORRECT REPRESENTATION
OF THE LOT LINES TO THE BEST OF MY
KNOWLEDGE AND BELIEF.

Harold H. Kolb

HAROLD H. KOLB
WISCONSIN REGISTERED LAND SURVEYOR, S-187

DATE June 30, 1981

118-641 ✓