


FARRIS, HANSEN & COOPER, INC.

ENGINEERING, SURVEYING AND LAND PLANNING
715 W. WALWORTH ST. - P.O. BOX 487 - ELKHORN, WI 53121
OFFICE: 414/723-2098

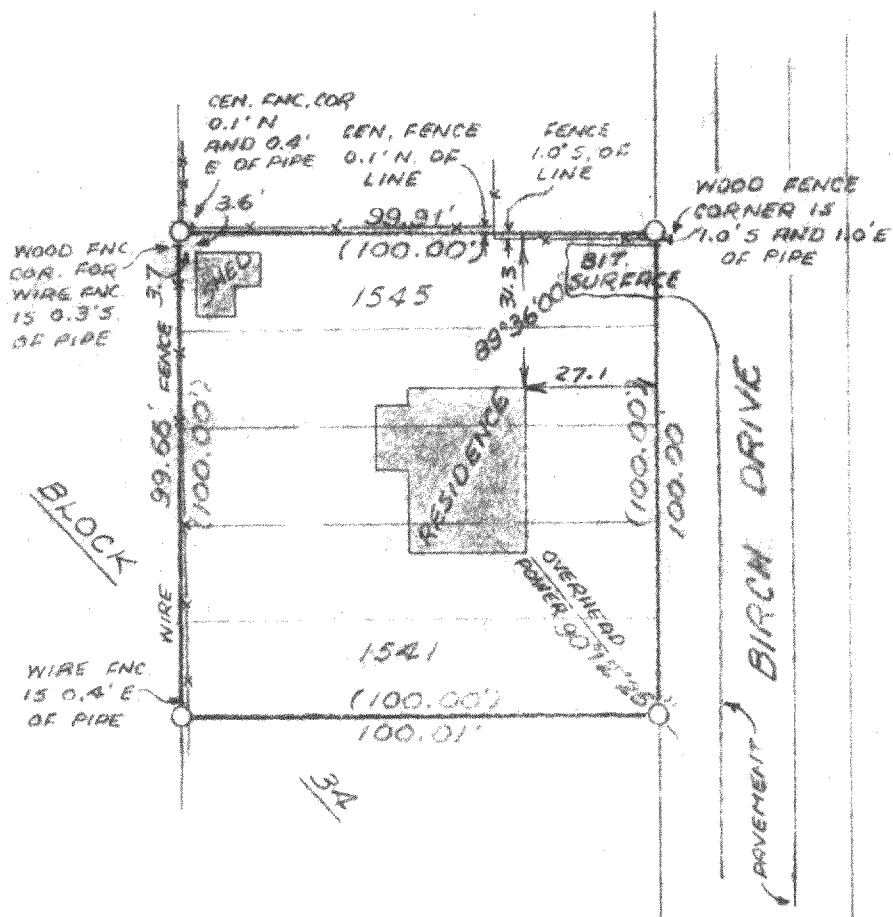

LEGEND

- O - IRON PIPE FOUND (1 5/8")
- () - RECORD DIMENSION

ORDERED BY:

JAN SPENCER
c/o THE PROPERTY
SHOPPE

PLAT OF SURVEY OF


LOTS 1541-1545, BLOCK 34, PELL LAKE SUBDIVISION,
WALWORTH COUNTY, WISCONSIN.

I HEREBY CERTIFY that at the direction of
Jan Spencer I have surveyed the above described
lots and that this Plat of Survey is a true
and accurate representation of the lot lines and
structures shown to the best of my professional
knowledge and belief.

Robert A. Farris

Robert A. Farris, R.L.S. No 1293

Dated this 9 day of Nov., 1982

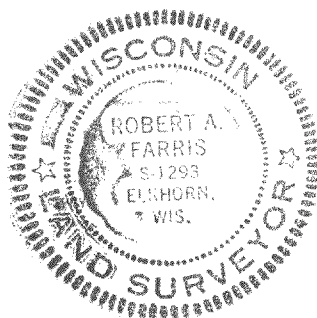

DRAWING NUMBER 2016

118-641-F ✓