



KOLB LAND CONSULTING, INC.
LAND SURVEYING • SUBDIVIDING • LAND PLANNING

LAKE GENEVA, WISCONSIN 53147

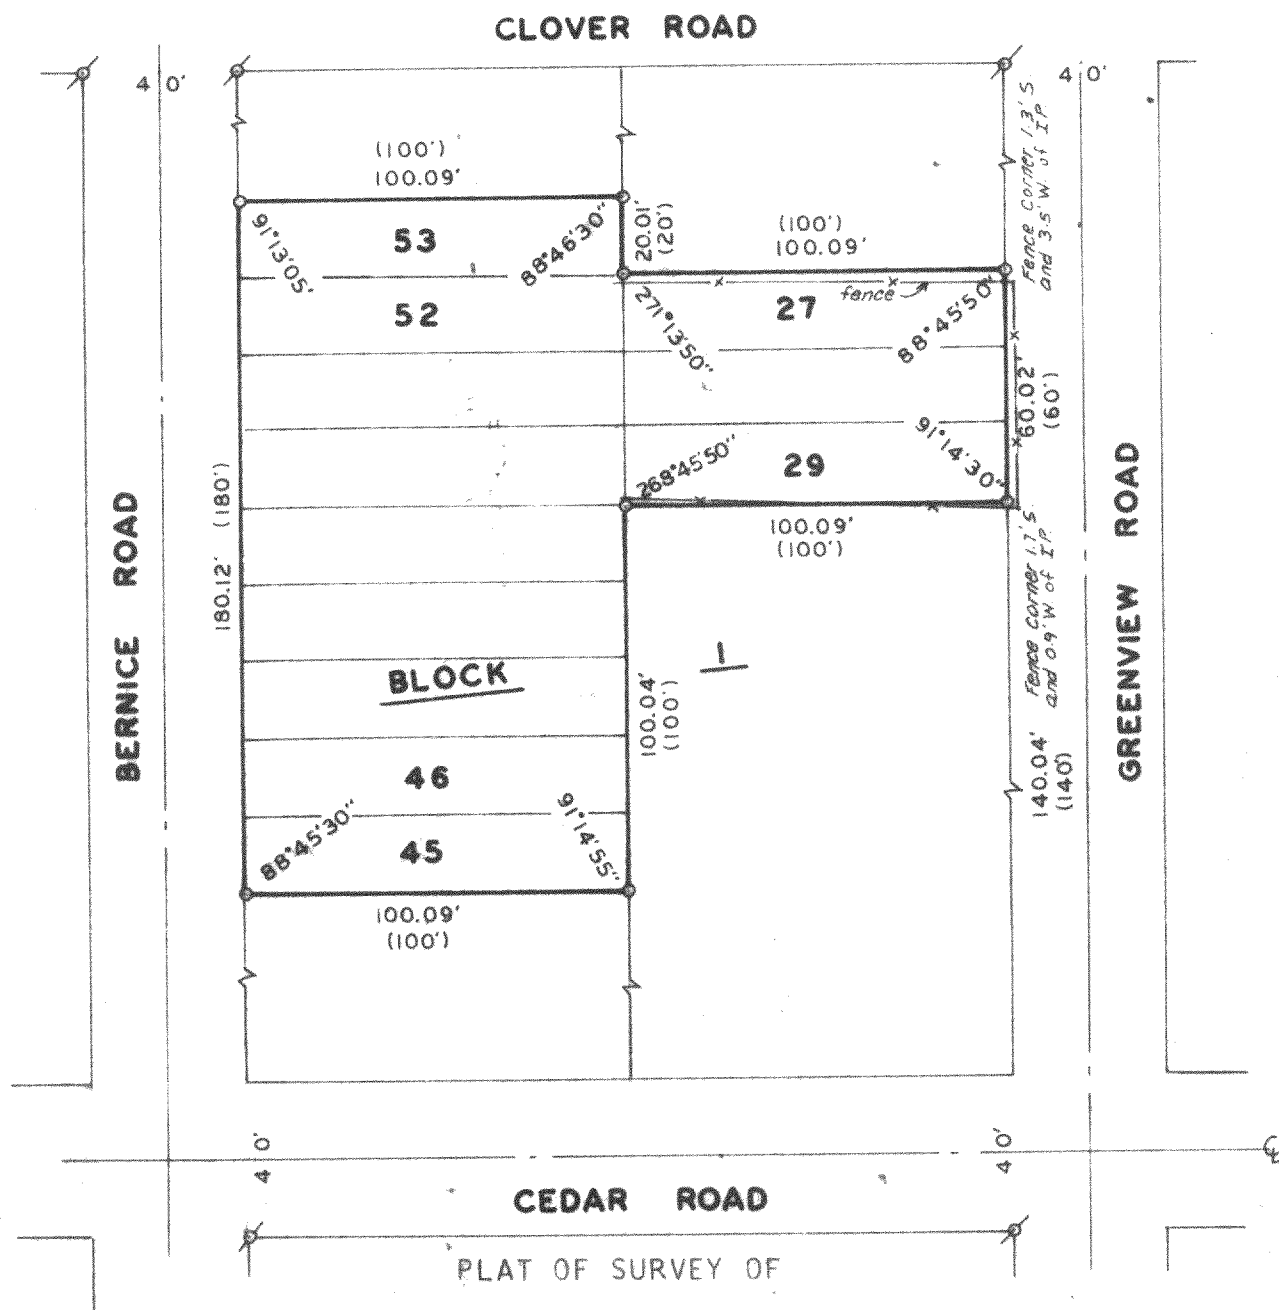

LOTS 27-29, 45-53, BLOCK 1, PELL LAKE HIGHLANDS, T1N, R18E, WALWORTH COUNTY, WISCONSIN.

ORDERED BY: IWAN PANKO
P.O.B. 494
PELL LAKE, WI 53157

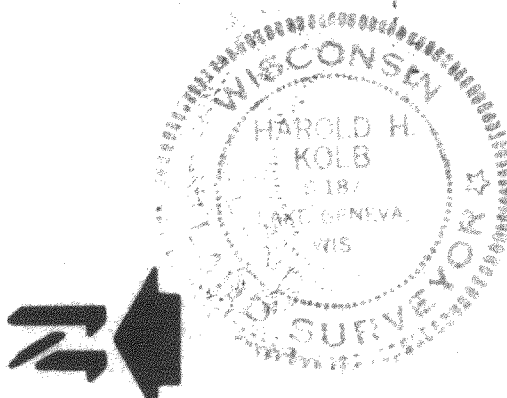

I, HAROLD H. KOLB, DO HEREBY CERTIFY THAT I HAVE SURVEYED THE PROPERTY HEREON DESCRIBED ACCORDING TO THE OFFICIAL RECORDS, AND THAT THE PLAT HEREON IS A CORRECT REPRESENTATION OF THE LOT LINES TO THE BEST OF MY KNOWLEDGE AND BELIEF.

SCALE - 1"=50'

LEGEND
○ IRON PIPE FOUND
○ IRON PIPE SET
() RECORDED AS

Harold H. Kolb
HAROLD H. KOLB
WISCONSIN REGISTERED LAND SURVEYOR, S-187
DATE SEPTEMBER 14, 1984

MDLH-11

118-66TK