

PLAT OF SURVEY
OF


THE WEST 209.0 FEET OF THE NORTH 209.0 FEET OF THE NORTHEAST 1/4 OF SECTION 36, T. 1 N.,
R. 18 E., OF THE 4TH P.M., TOWN OF BLOOMFIELD, WALWORTH COUNTY, WISCONSIN.

FOR: LEE M. FARRELL

○ = IRON PIPE STAKE SET



■ = CONCRETE MONUMENT FOUND

SCALE: 1" = 40'

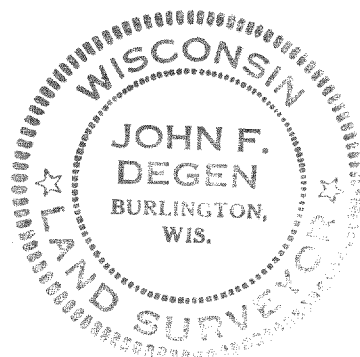

NORTH 1/4
SECTION 36
T. 1 N.
R. 18 E.

N. 2 NE 1/4 SEC. 36-1-8

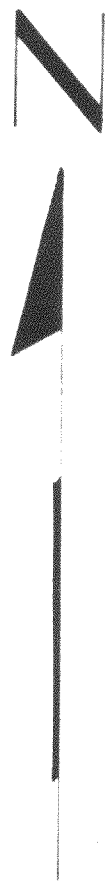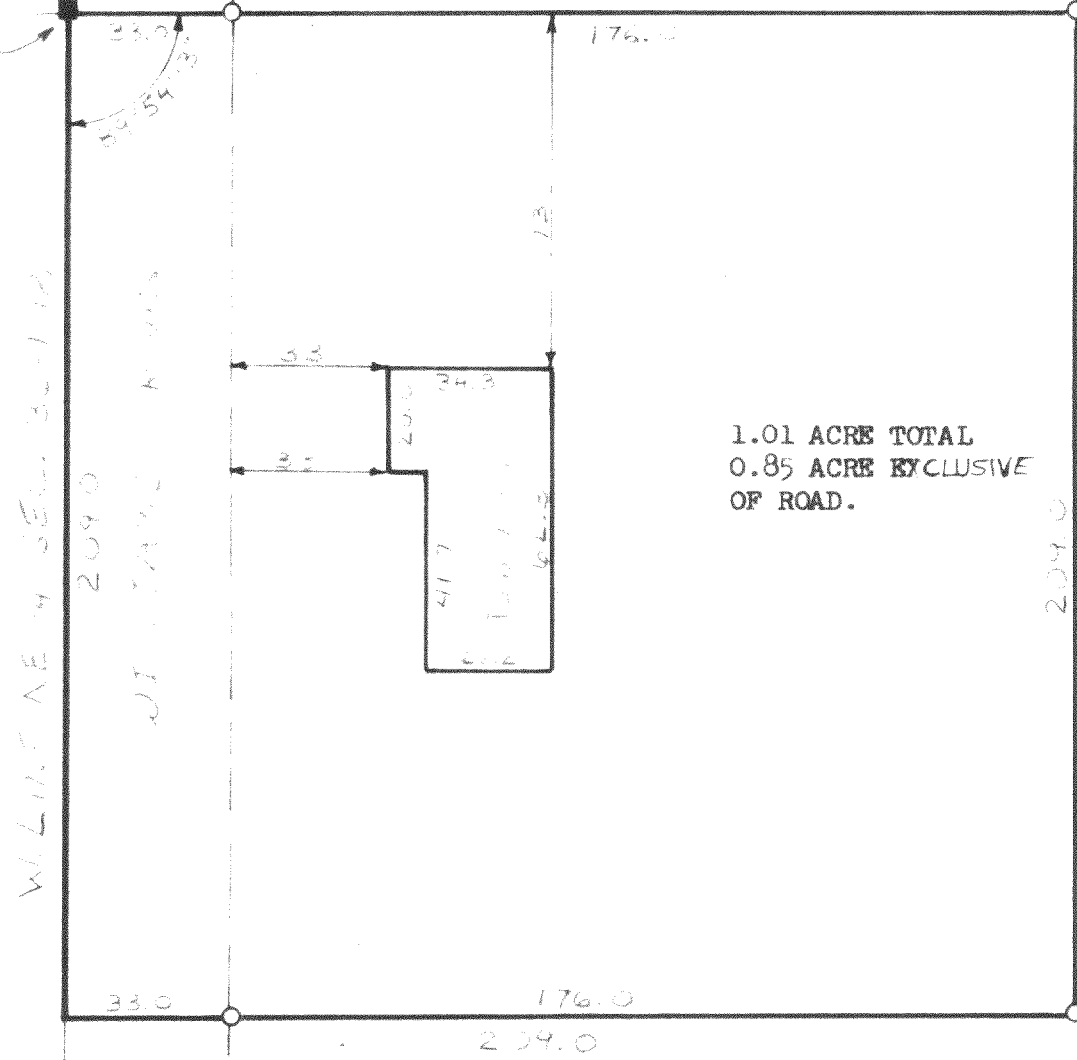

W. 1/2 NE 1/4 SEC. 36-1-8
T. 1 N.
R. 18 E.

Farrell
B-36-3E

118-665 ✓
11-2-2 #22