

PLAT OF SURVEY OF

LOT 20 OF NIPPERSINK HIGHLANDS, A SUBDIVISION LOCATED IN THE NE 1/4 OF THE NE 1/4 AND THE NW 1/4 OF THE NE 1/4 OF SECTION 24, BEING IN GOVERNMENT LOT 1 OF SECTION 24, TOWN 1 NORTH, RANGE 18 EAST WALWORTH COUNTY, WISCONSIN.
(ABOVE LOCATION BEING IN THE TOWN OF BLOOMFIELD.)


FOR: LARRY HODGES CENTURY 21 REALTY

SCALE 1" = 30'

BEARING DATUM IS THAT
OF RECORDED PLAT.

Ø = IRON PIPE STAKE FOUND.

○ = IRON PIPE STAKE SET.

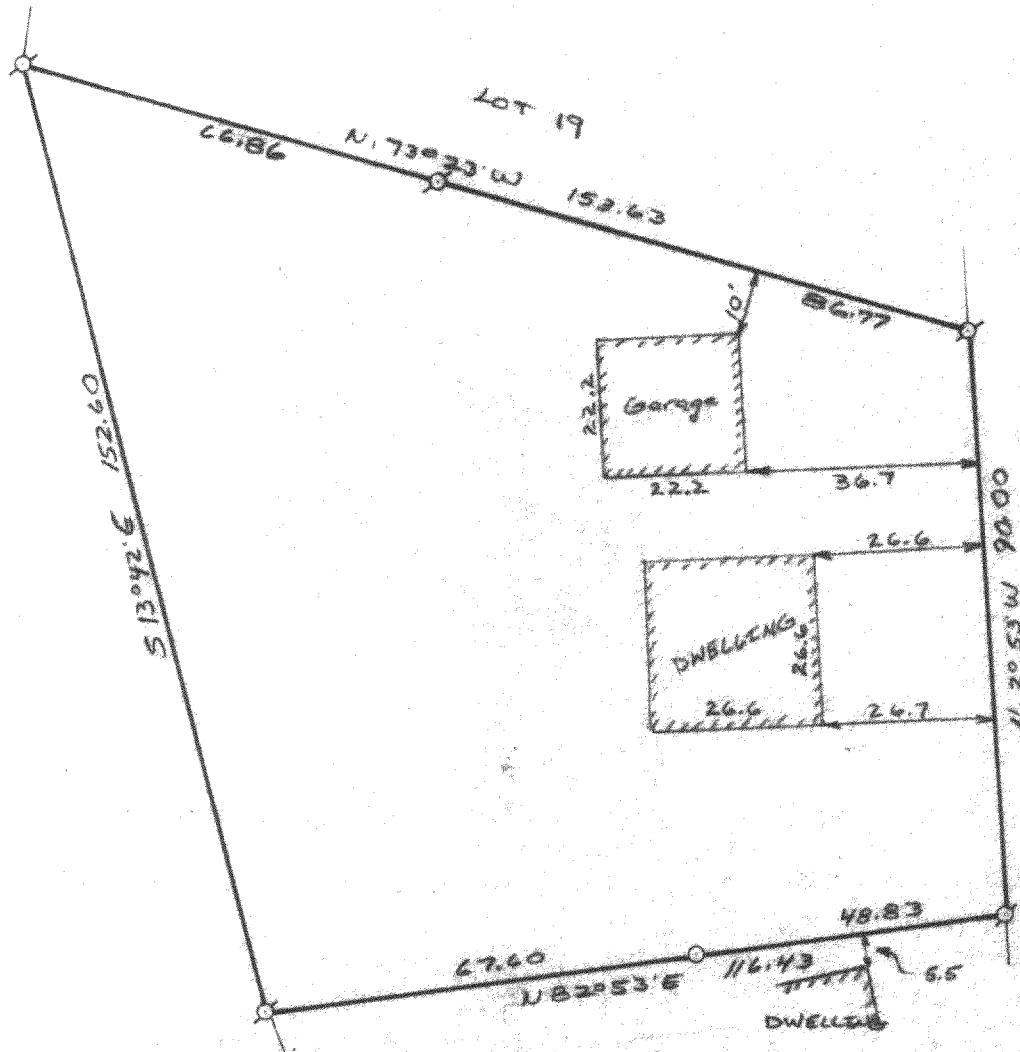


I have surveyed the above-described property and the map hereon is a true representation thereof and shows the size and location of the property, its exterior boundaries, the location and dimensions of all visible structures thereon, fences, apparent easements and roadways and visible encroachments, if any.

This survey is made for the exclusive use of the present owners of the property, and also those who purchase, mortgage, or guarantee the title thereto, within one year from date hereof.

Dated at Burlington, this 5th day
of MARCH 1986

John F. Degen
John F. Degen, Land Surveyor 5242

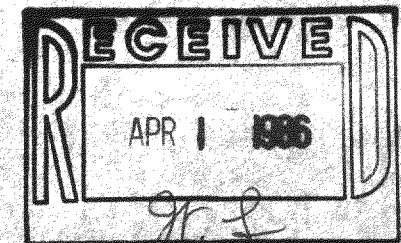

118-686D