




NW CORNER OF
NW 1/4 SECTION 17, TIN RIBE
AS FENCED

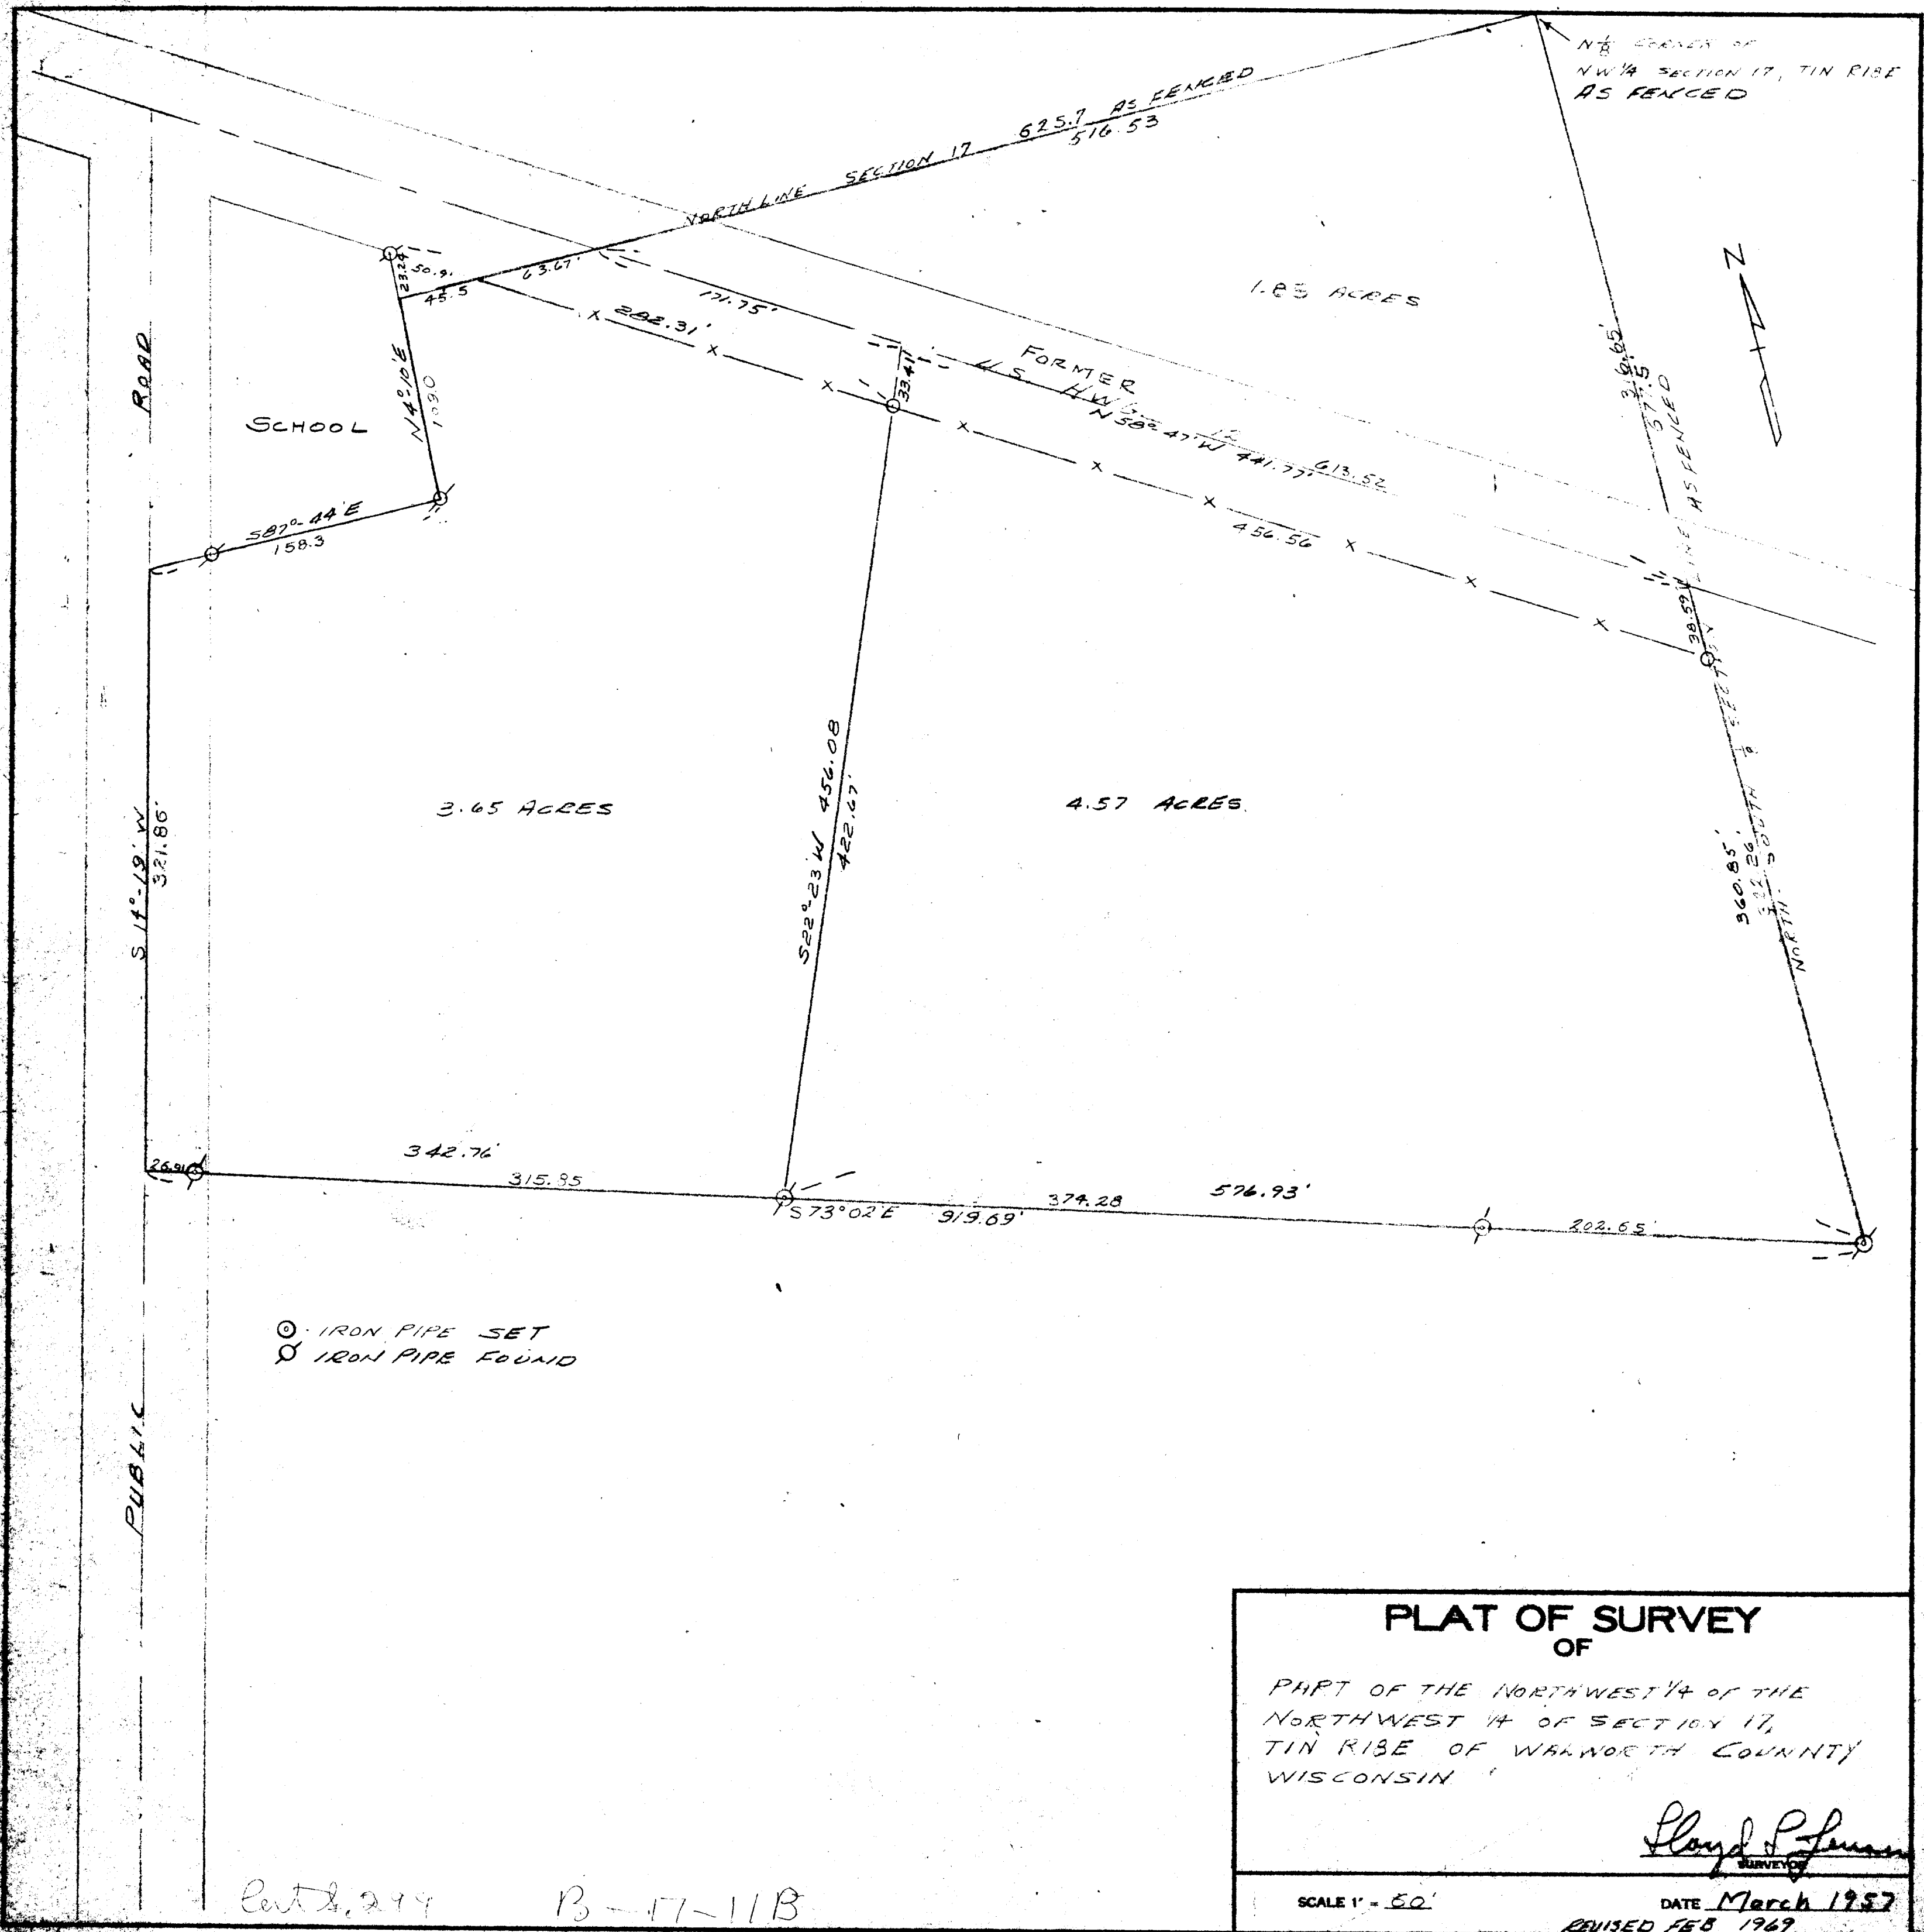

⊙ IRON PIPE SET
⊘ IRON PIPE FOUND

Cont'd. 299

B-17-11B