


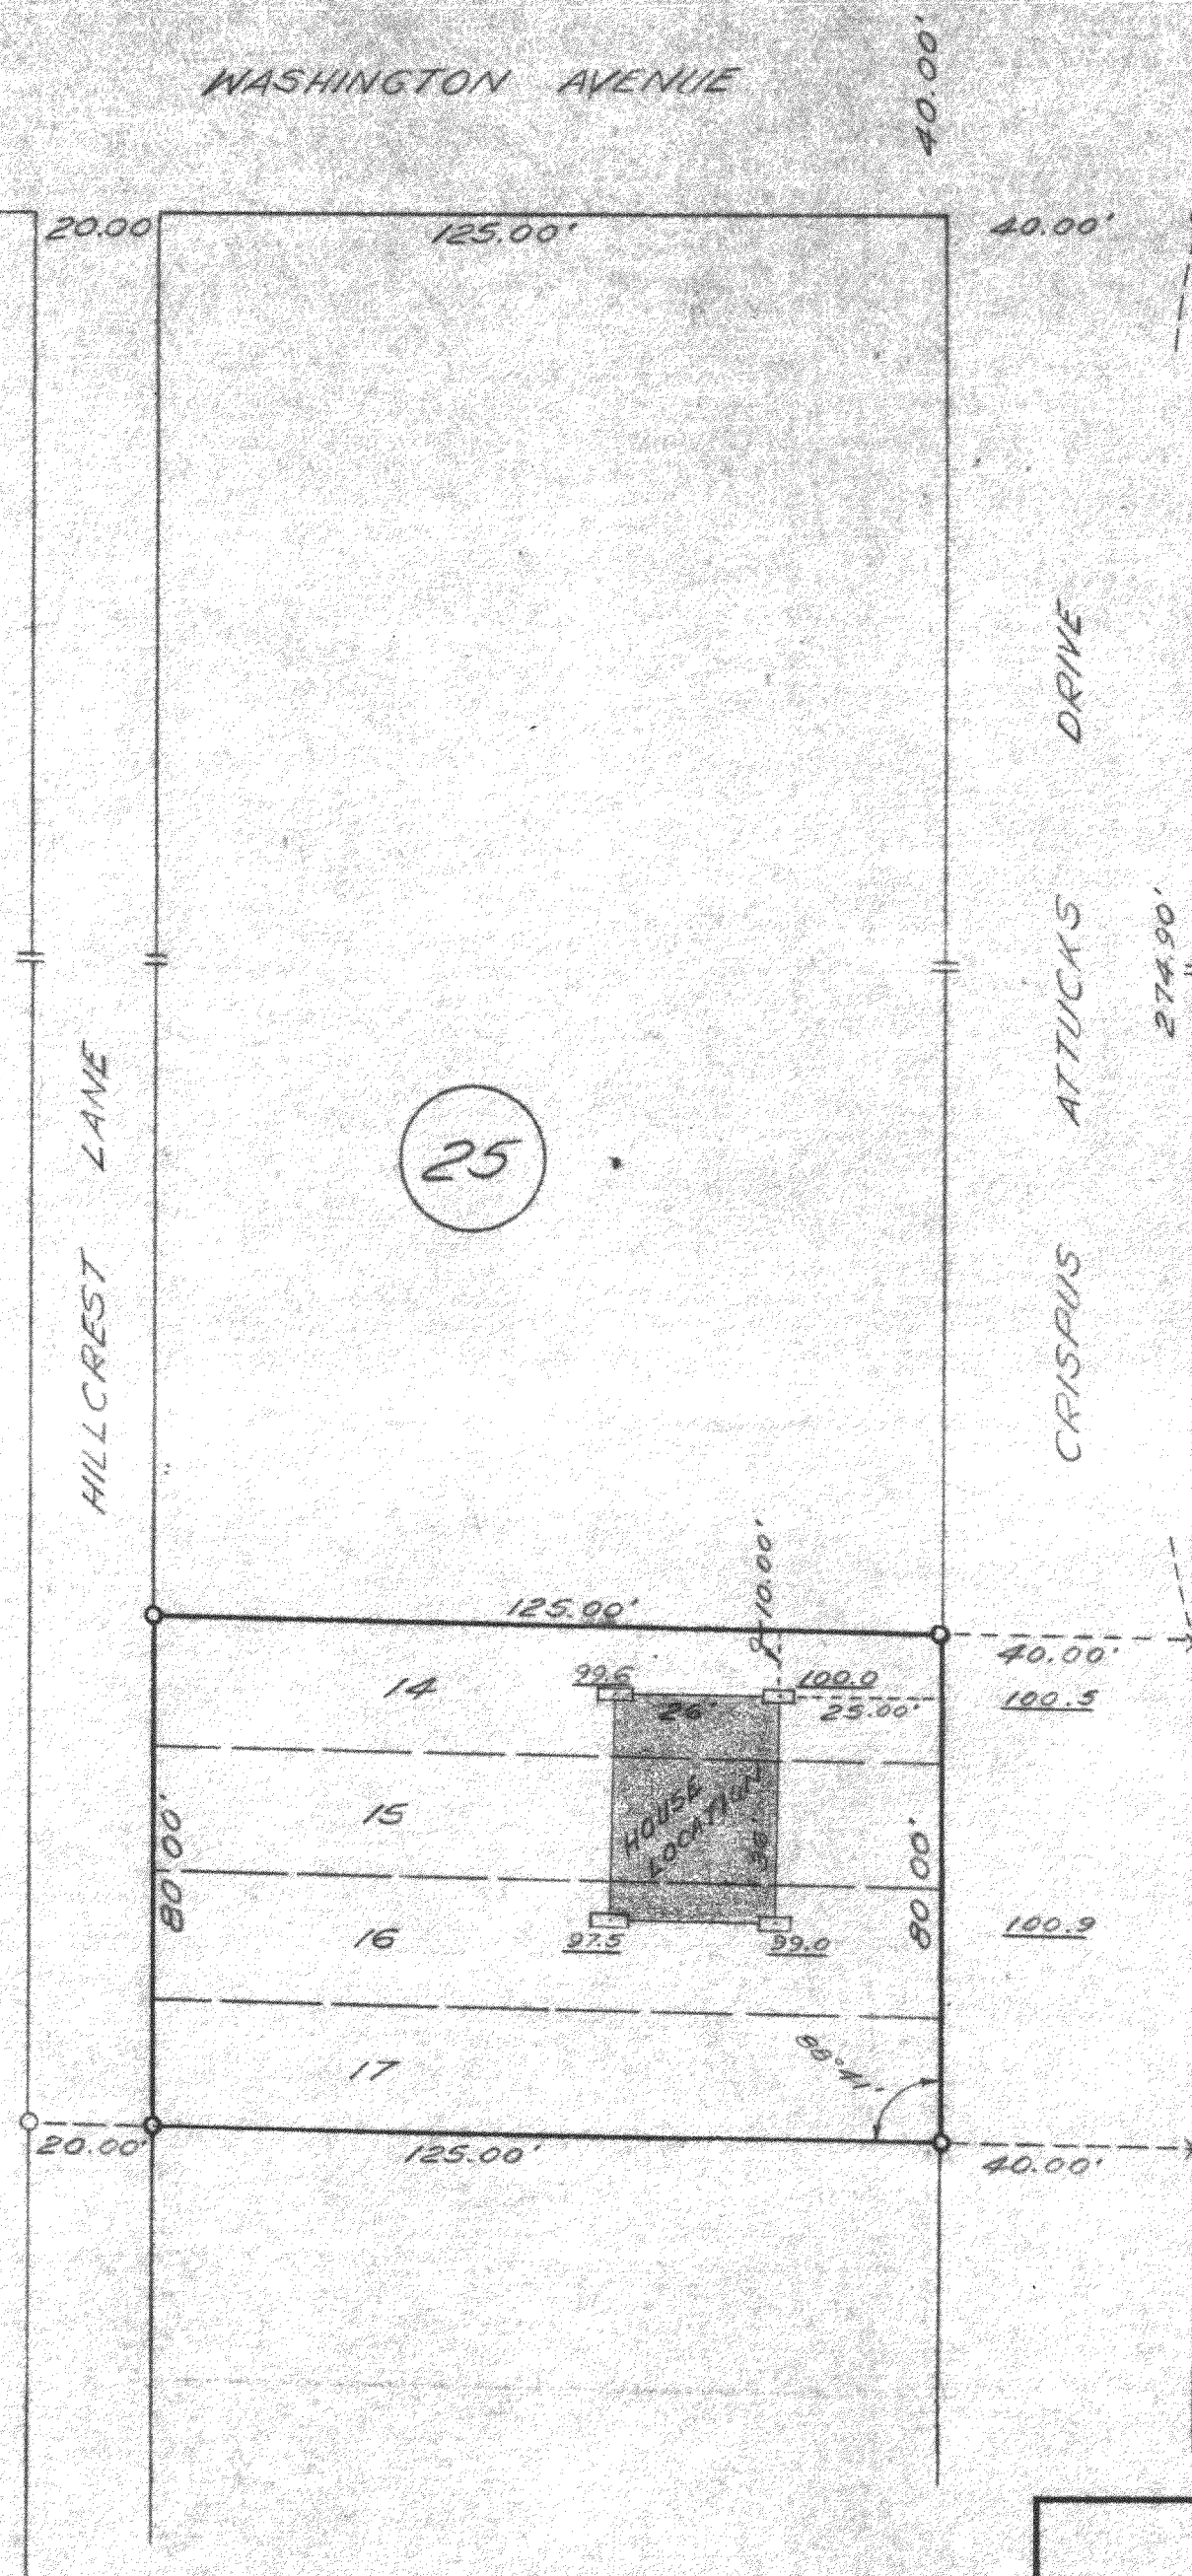

O IRON PIPE
 □ WOOD STAKE & TACK
 X SPIKE
 100.9 ELEVATIONS AT HOUSE CORNERS
 & ROAD (GROUND ELEVATION)

PLAT OF SURVEY OF

LOTS 14-17, BLOCK 25, LAKE IVANHOE
 RESORT, LOCATED IN T1N, R1E, WALWORTH
 COUNTY, WISCONSIN.

Lloyd L. Jensen
 SURVEYOR

SCALE 1" = 30'

DATE JANUARY, 1962

MIR-428

118-77.1