

Block 134

MARGUERITE ROAD


Lot 6013: Dimensions: 99.83' (100'), 89°56'15", 11.8', 35.0', 90°06'53".

Lot 6012: Dimensions: 12.3', 7.9', 22.8', 20.5', 12.5', 10', 22.6', 38.4'. Contains a **HOUSE**.

Lot 6011: Dimensions: 14.1', 14.1', 9.4', 10.2', 9.4'. Contains a **SHED**.

Other Lots: 6010, 6009, 6008, 6007, 6006, 6005. Right side dimensions: 99.99' (100'), 89°48'50", 90°08'00".

Block Dimensions: 179.90' (180') along Marguerite Road.

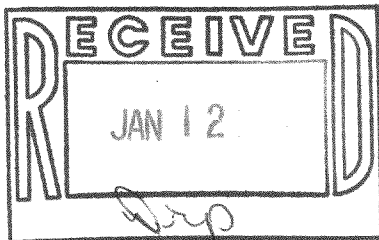

LOTS 6005-6013, BLOCK 134 OF SECTION
4 OF PELL LAKE, LOCATED IN T 1 N, R 18 E,
WALWORTH COUNTY, WISCONSIN.

♂ - IRON PIPE FOUND
 ○ - IRON ROD PLACED
 () - RECORDED AS

Robert M. Baerenwald
ROBERT M. BAERENWALD
WISCONSIN REGISTERED LAND SURVEYOR, S-1508

DATE Dec. 12, 1987 JOB NO. 1354

NOTE: THIS IS NOT A CERTIFIED COPY UNLESS SEALED.