


M A R I N E T T E

ROAD

2

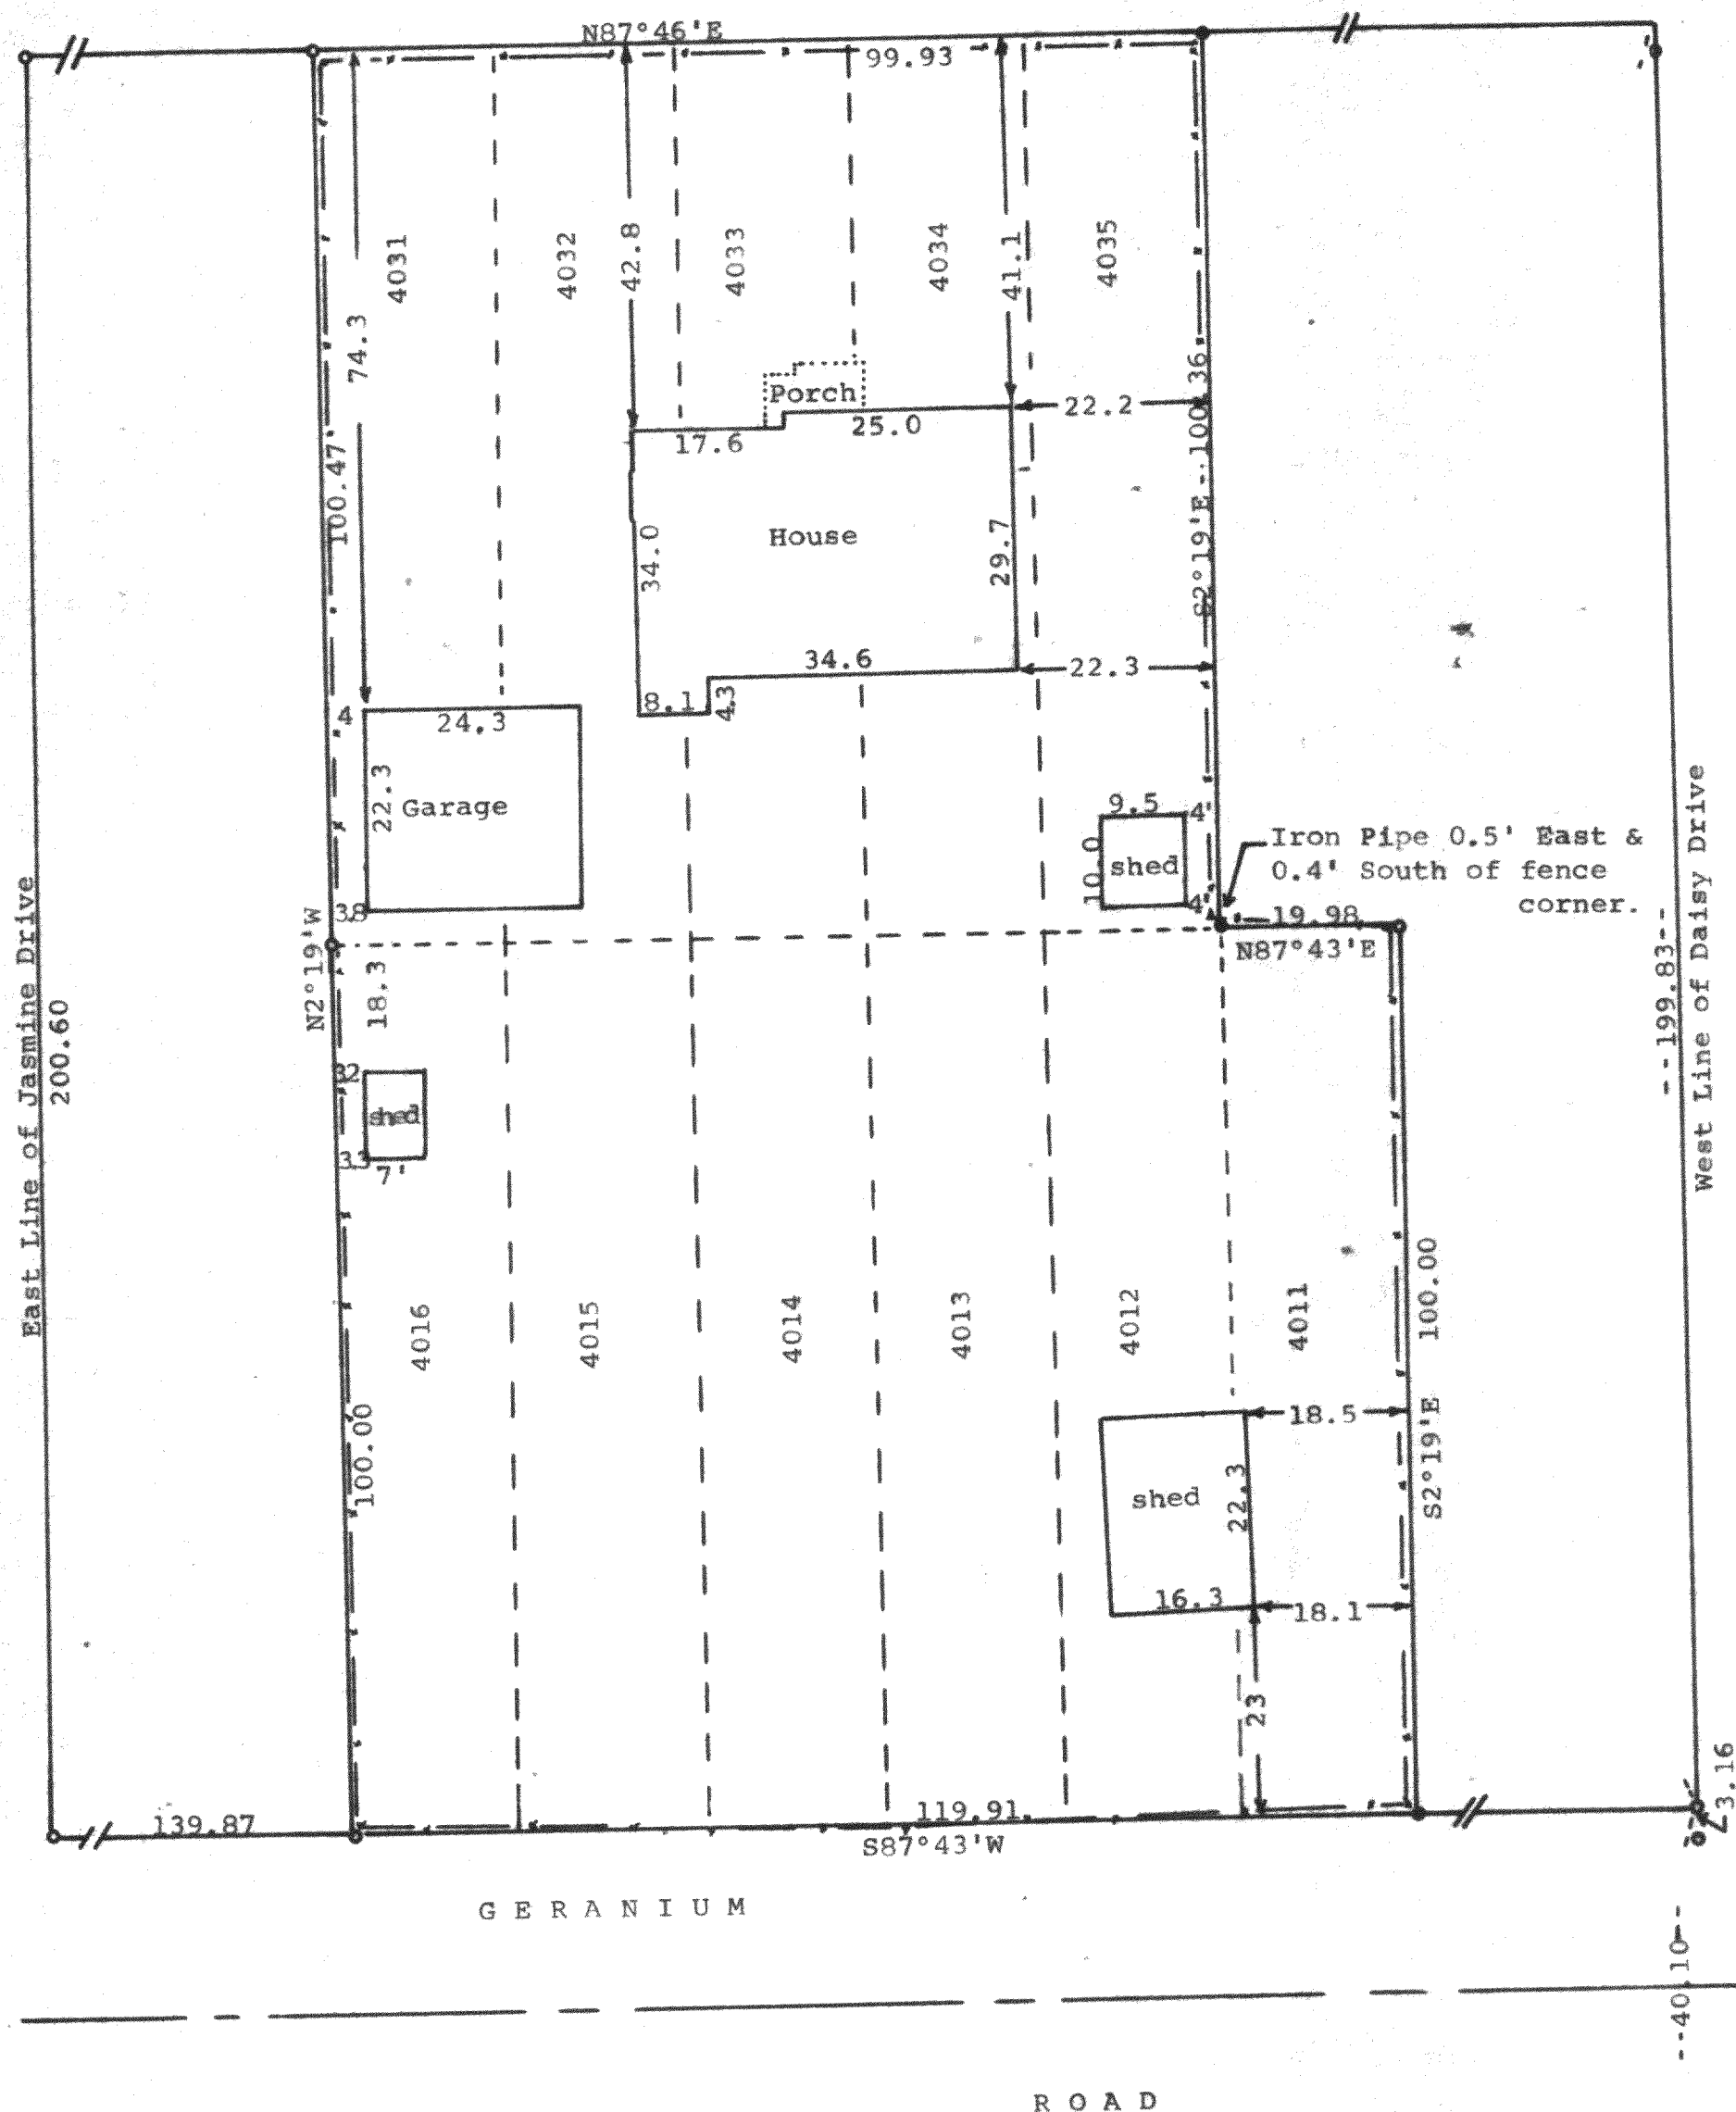

● = 1" Iron Pipe Found
● = 3/4" Iron Pipe Found

----- = Fence Line
Bearings referenced to the recorded
bearing of N87°46'E along the south
line of Marinette Drive
Survey ordered by:
Barb Lepkowski, Realtor
484 Orchard Street
Antioch, IL 60002

George F. Dunham
George F. Dunham, Surveyor

