



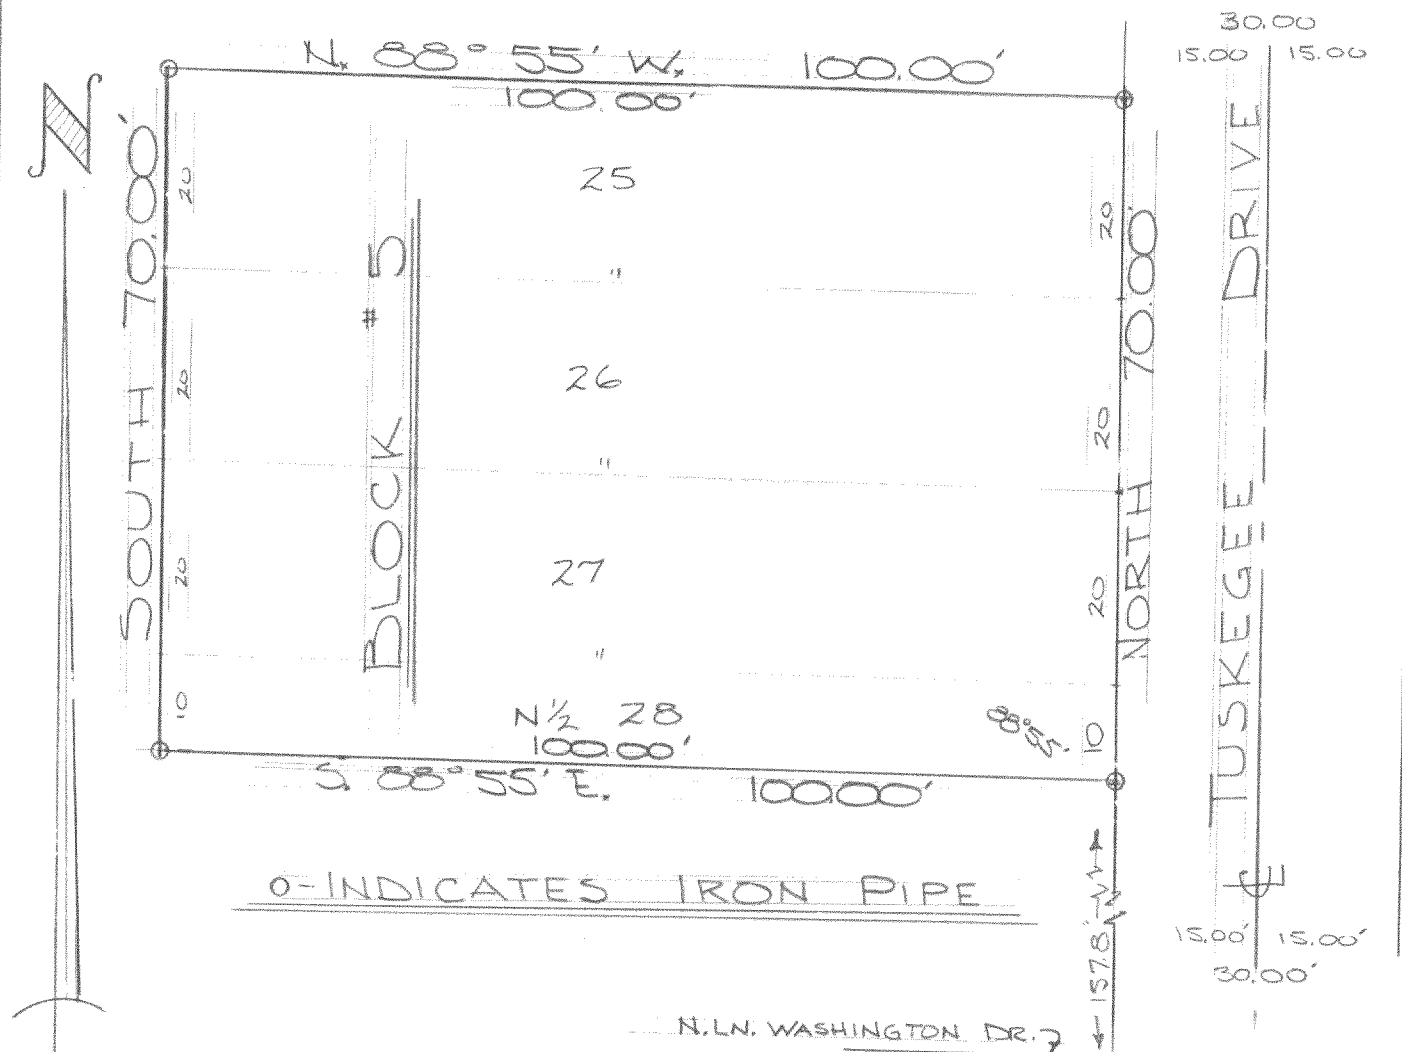

DESCRIPTION: Lots 25, 26, 27, and the N $\frac{1}{2}$ of Lot 28 of Block #5 of Lake Ivanhoe Resort Subdivision, located in Walworth County, Wisconsin.

CERTIFICATE: I, James F. Biagi, surveyor, do hereby certify that I have surveyed the property hereon described.

September 24, 1968.

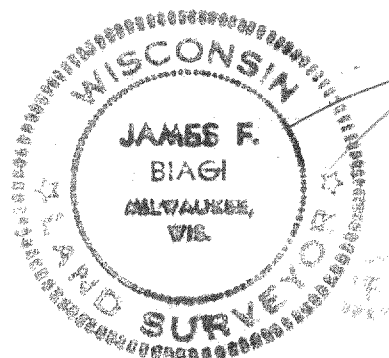

James F. Biagi, RLS 272