


KOLB LAND CONSULTING, INC.
LAND SURVEYING • SUBDIVIDING • LAND PLANNING

92 WILLIAMS STREET LAKE GENEVA, WISCONSIN 53147 414-248-3697

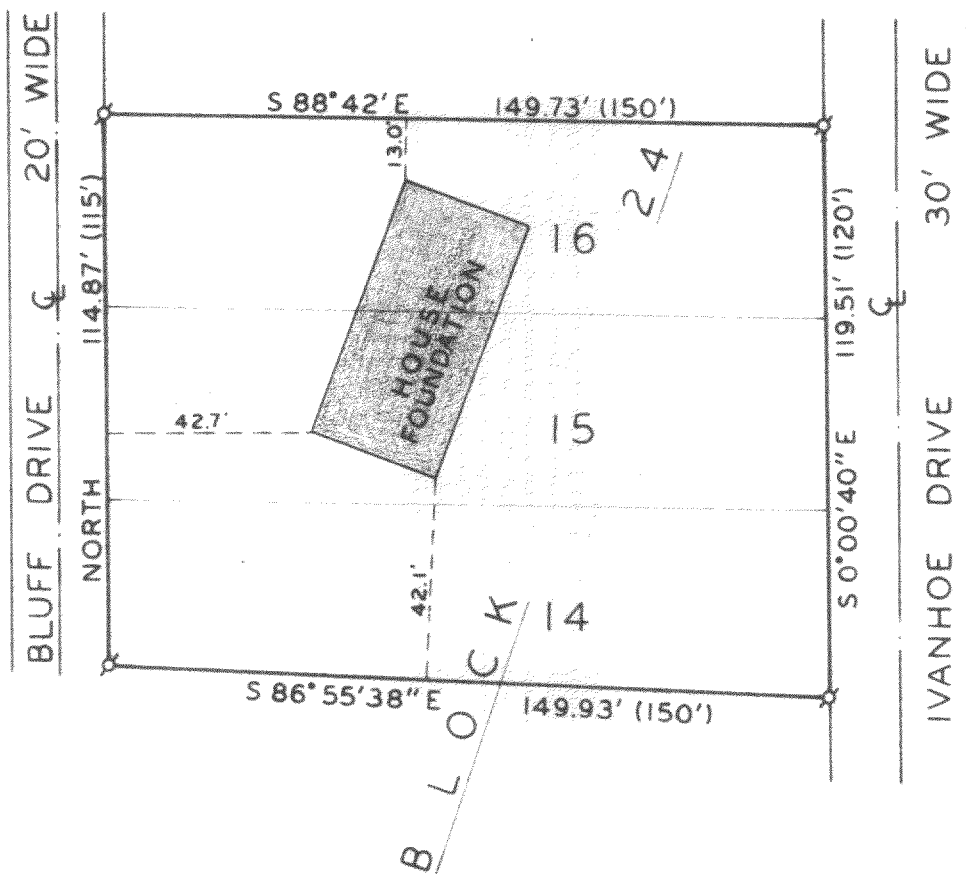


PLAT OF SURVEY OF

LOTS 14, 15 AND 16 OF BLOCK 24, LAKE IVANHOE RESORT SUBDIVISION,
LOCATED IN THE SOUTHEAST 1/4 OF SECTION 34, T2N, R18E, AND IN THE
NORTHEAST 1/4 OF SECTION 3, T1N, R18E, WALWORTH COUNTY, WISCONSIN.

NOTE: BEARINGS ARE ASSUMED FROM PREVIOUS SURVEY.

ORDERED BY: FIVE STAR HOMES
90 EAST GENEVA SQUARE
LAKE GENEVA, WI 53147

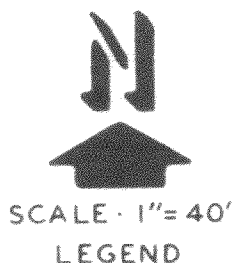

Ø - IRON PIPE FOUND

I, HAROLD H. KOLB DO HEREBY CERTIFY
THAT I HAVE SURVEYED THE PROPERTY
HEREON DESCRIBED ACCORDING TO THE
OFFICIAL RECORDS, AND THAT THE PLAT
HEREON IS A CORRECT REPRESENTATION OF
THE LOT LINES AND FOUNDATION TO THE
BEST OF MY KNOWLEDGE AND BELIEF.
SURVEY NOT VALID UNLESS SURVEYOR'S
SIGNATURE IS IN RED.

HAROLD H. KOLB

WISCONSIN REGISTERED LAND SURVEYOR, S-187
DATE NOVEMBER 17, 1987

REVISED _____

REVISED _____