Plat of Survey

FOR KEITH JOHNSON REALTY


SITUATED ON VIOLET ROAD, IN THE TOWN OF BLOOMFIELD, WISCONSIN.

LOT 16 IN BLOCK 4 IN ROSE NIPPERSINK GARDENS, BEING A SUBDIVISION OF A PART OF THE SE 1/4 AND A PART OF THE SW 1/4 OF THE SE FRACTIONAL 1/4 OF SECTION 24, T 1 N, R 18 E, IN THE TOWN OF BLOOMFIELD, WALWORTH COUNTY, WISCONSIN.

APRIL 7, 1989

ANDREW MC MANUS

SURVEY NO. 152863-S

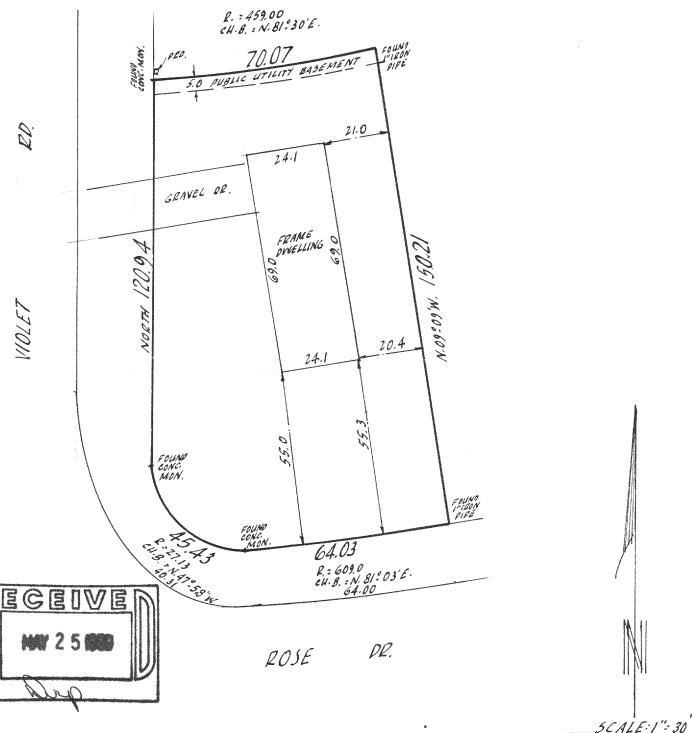

I Certify that I have surveyed the above described property (Property), and the above map is a true representation thereof and shows the size and location of the Property, its exterior boundaries, the location and dimensions of all visible structures thereon, boundary fences, apparent easements and roadways and visible encroachments, if any.

This survey is made for the exclusive use of the present owners of the Property, and also those who purchase, mortgage, or guarantee the title thereto, within one (1) year from date hereof.





118-863