
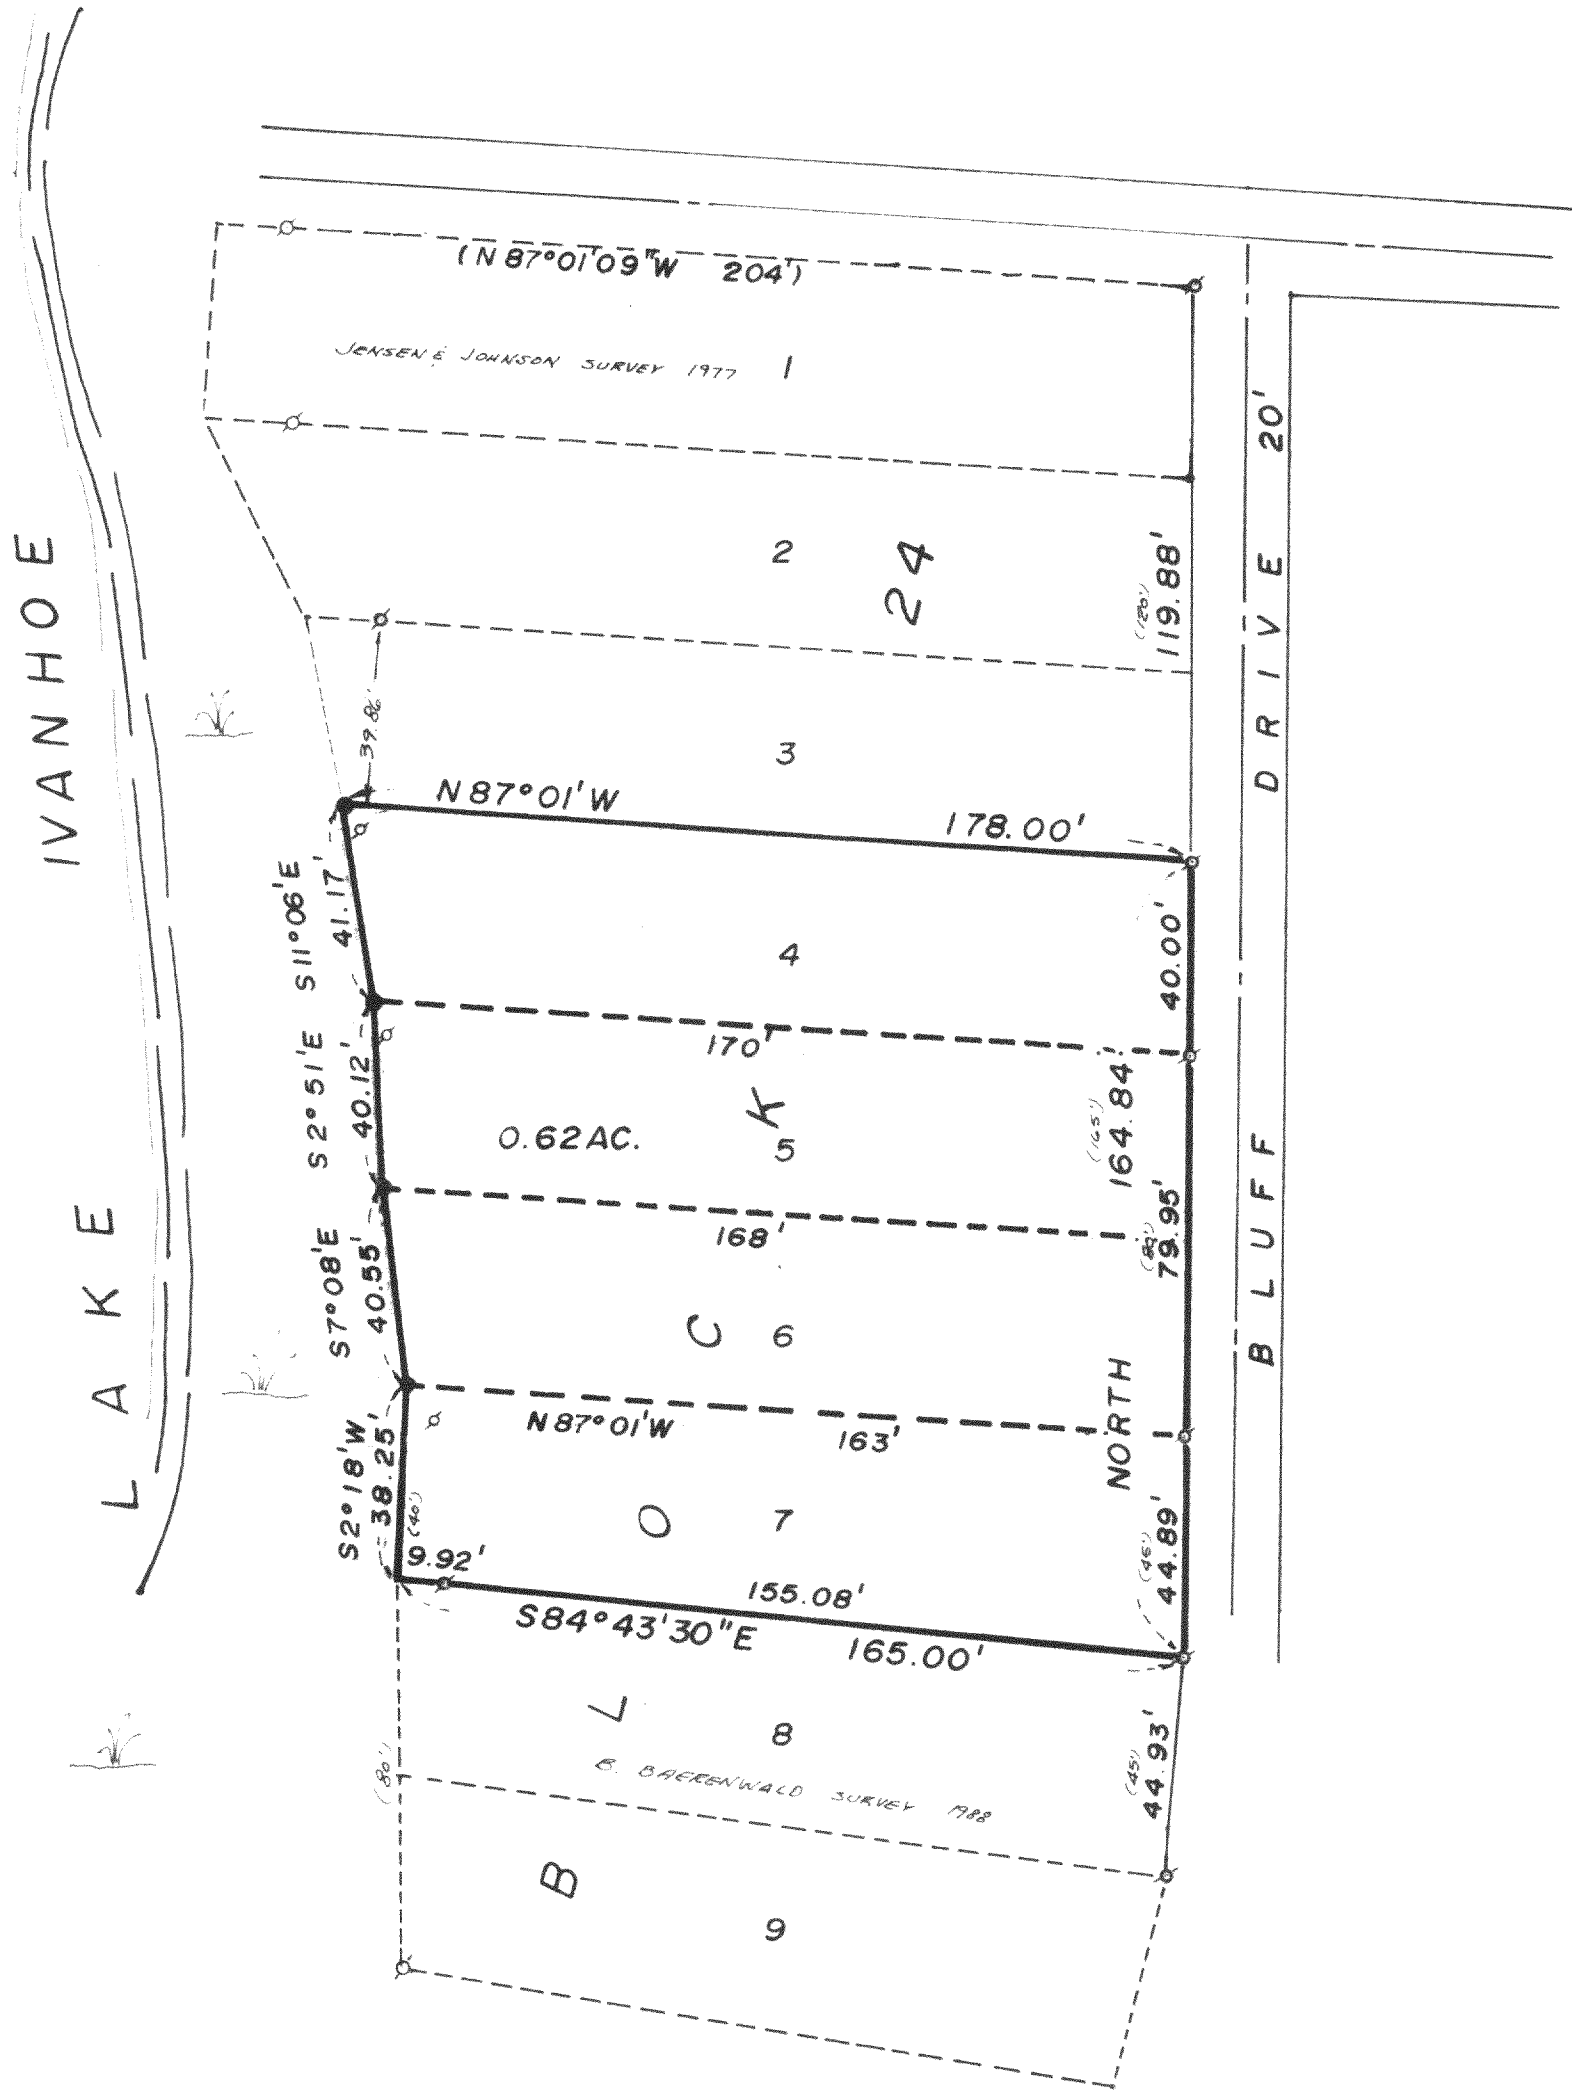


PLAT OF SURVEY

Lots 4, 5, 6, and 7 of Block 24 of Lake Ivanhoe Resort  
Located in Town 1 North, Range 18 East, Town of Bloomfield,  
Walworth County, Wisconsin.

Owner: Carlos Tronshaw  
1315 97th Place  
Chicago, Ill. 60643

- Notes:
- 1) The west line of Bluff Drive was assumed to bear NORTH.
  - 2) Iron pipe were found along the west side of property but were not accepted as the lot corners. The lots were resurveyed using the recorded distances and lines were run parallel with the north line of the Block.

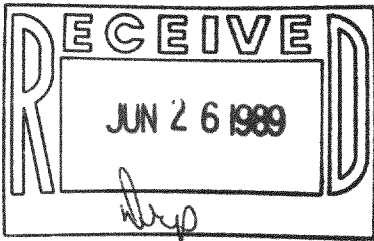

- Legend
- FOUND IRON PIPE
  - FOUND IRON ROD
  - FOUND BRASS CAPPED MONUMENT
  - FOUND CONCRETE MONUMENT
  - CHISEL CUT IN CONCRETE
  - SET IRON ROD, 24" LONG, WEIGHING 1.5 LBS./LINEAL FT., 3/4" DIA.
  - SET IRON ROD, 30" LONG, WEIGHING 4.5 LBS./LINEAL FT., 1-11/16" DIA.
  - RECORDED AS DIMENSION
  - EXISTING FENCE

SCALE: 1" = 40' FEET

119-867

"I hereby certify that I have surveyed the above described property and that the above map is a true representation thereof and shows the size and location of the property, its exterior boundaries, the location of all visible structures and dimensions of all principal buildings thereon, boundary fences, apparent easements, roadways and visible encroachments, if any."

"This survey is made for the use of the present owners of the property, and also those who purchase, mortgage, or guarantee the title thereto within one year from date hereof."

*Kenneth B. Abernathy, Jr.*  
KENNETH B. ABERNATHY, JR.  
WISCONSIN REGISTERED LAND SURVEYOR,  
S-1594

Date: 4/15/89 Job No. 86.1003