


CHAS. YOUNG DRIVE

DUNBAR BLVD.

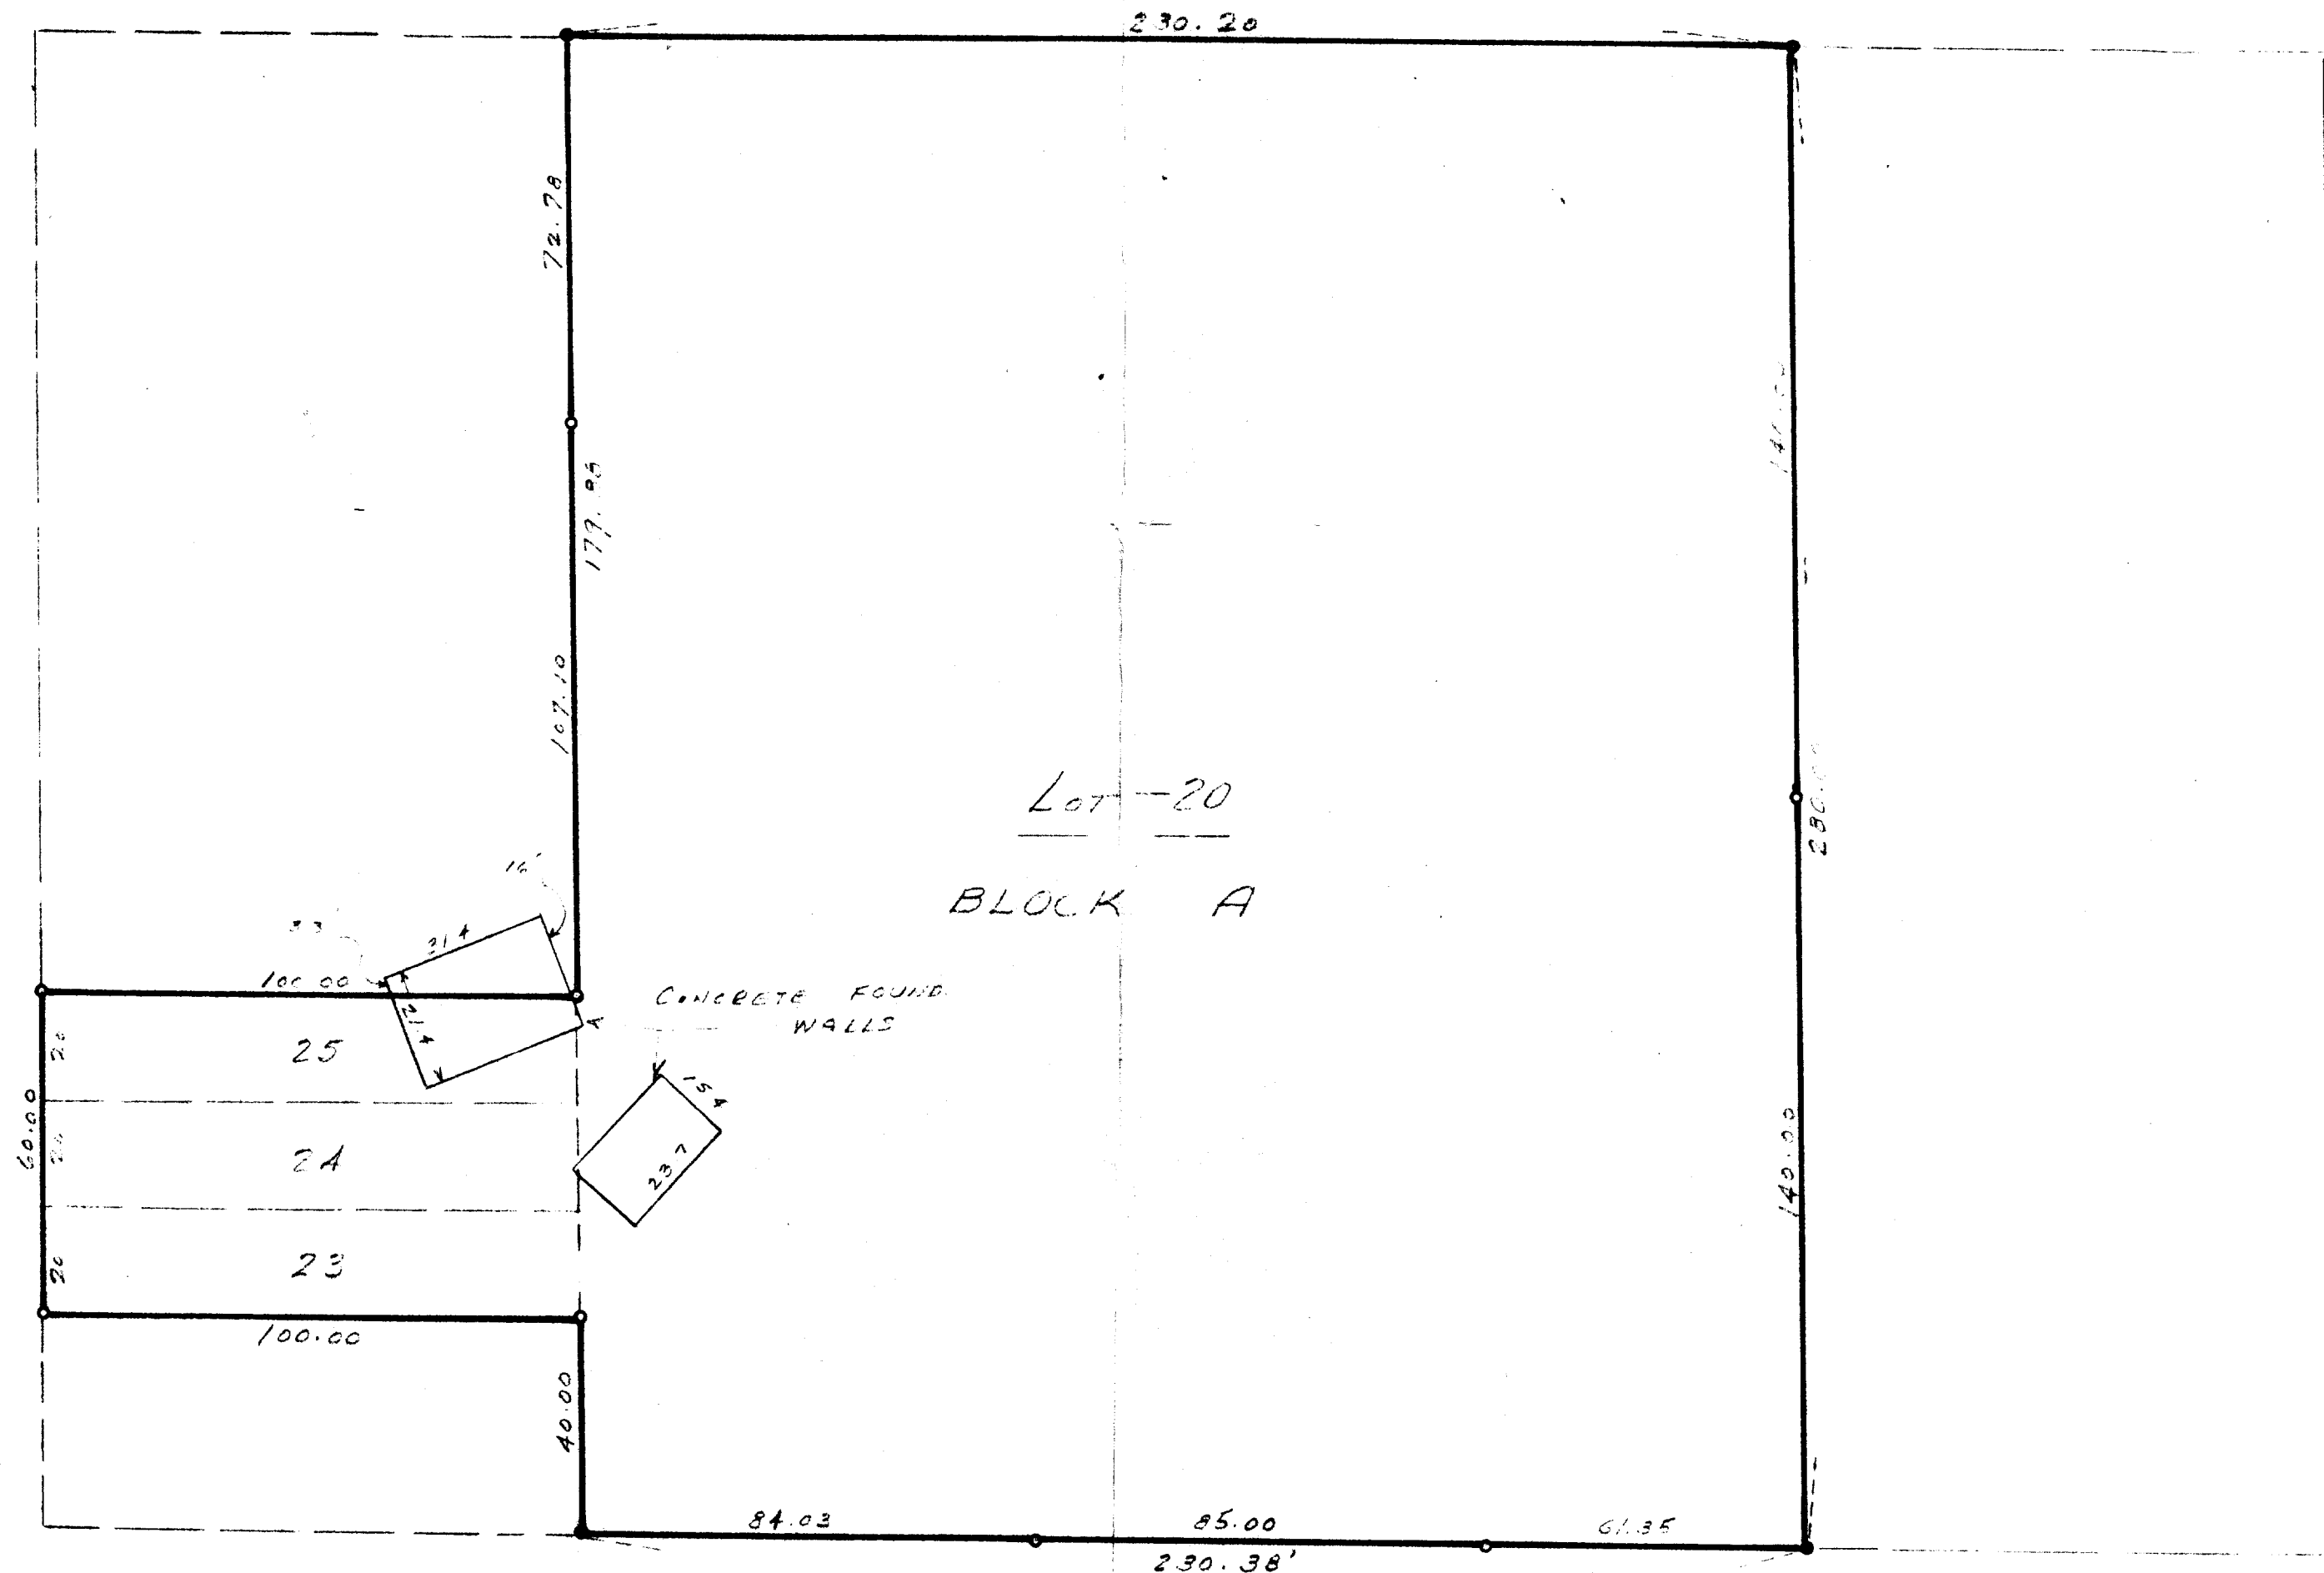

TUCKER DRIVE

LEGEND

- IRON STAKE
- CONC. MONUMENT

SETBACK 25'
REAR YARD 25'

PLAT OF SURVEY
OF

LOT 20-23-24-25 BLOCK A
LAKE ILWACO RES. AT
SECTION 2, T1N-31E
WASCO COUNTY, OR

George J. Wilson
SURVEYOR

SCALE 1" = 30'

DATE July 18, 1966