
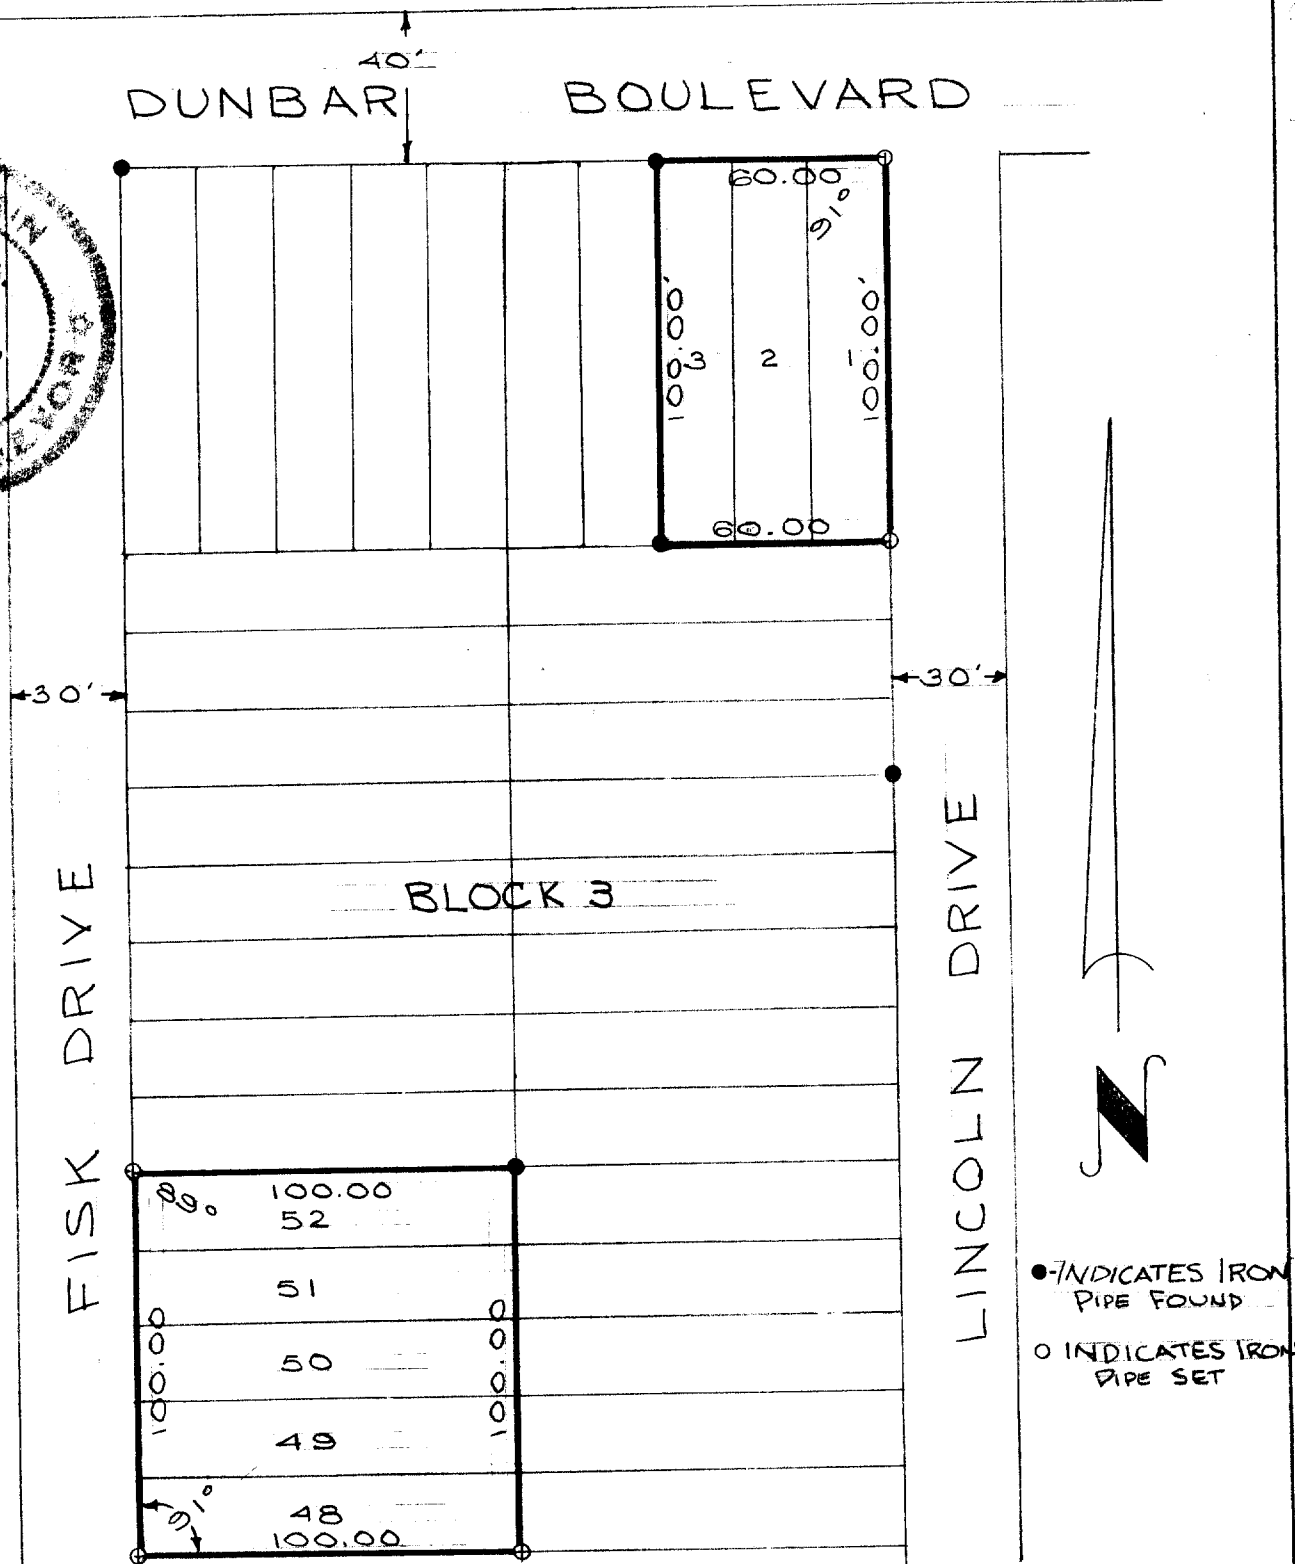


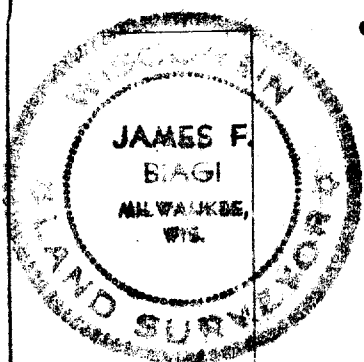

DESCRIPTION: Lots 1, 2, 3 48, 49, 50, 51, and 52, of Block 3, Lake Ivanhoe Resort a subdivision in Section 23, Town 1 North, Bloomfield Township, Walworth County, Wisconsin.

CERTIFICATE: I, James F. Biagi, surveyor, do hereby certify that I have surveyed the property hereon described.

DATE: June 29, 1971

James F. Biagi RLS 272  
Elkhorn, Wisconsin

118-91B