


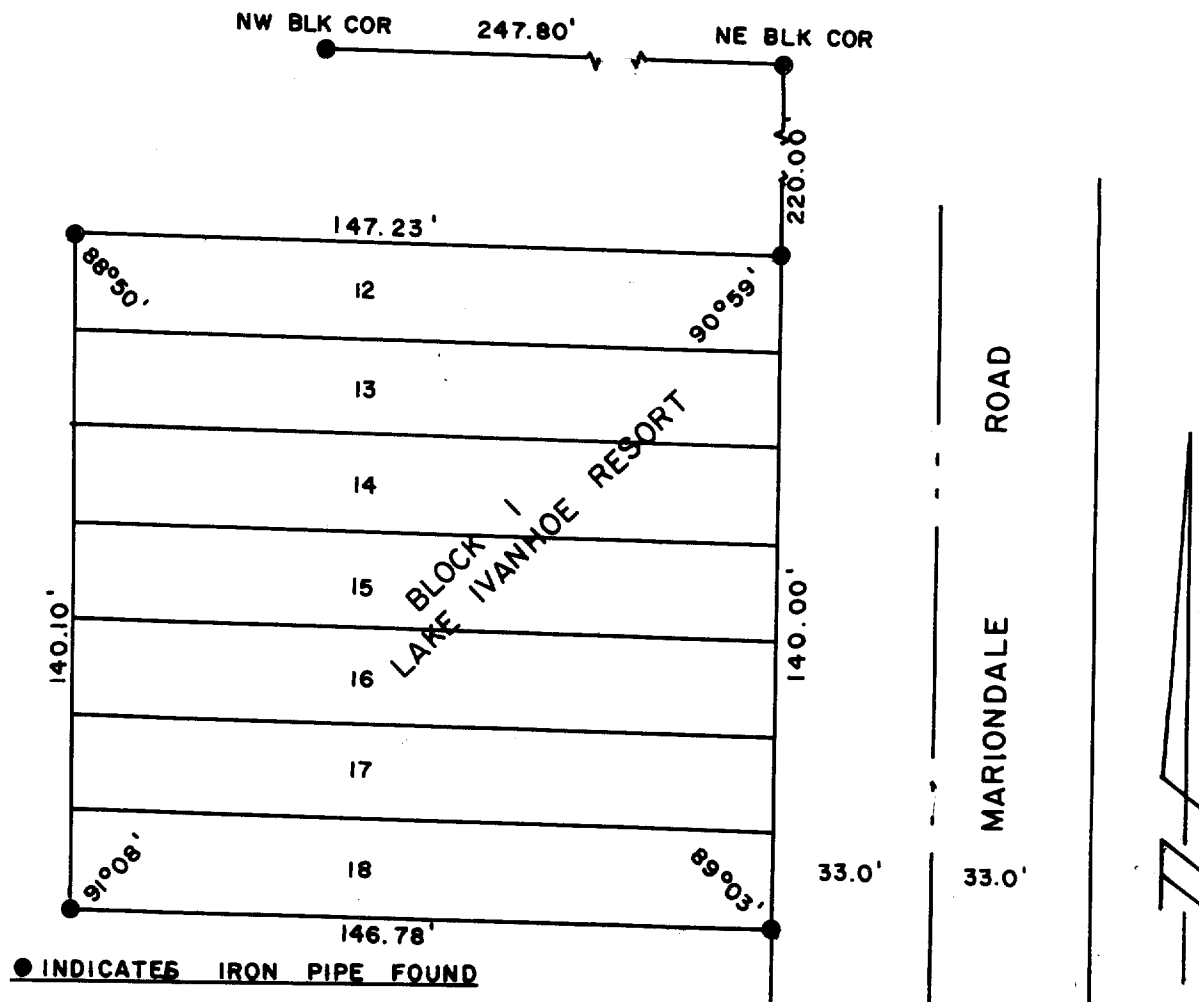

## PLAT OF SURVEY OF

Lots 12 thru 18 inclusive of Block 1 of Lake Ivanhoe Resort,  
Section 2, T1N, R18E, Walworth County, Wisconsin.


## CERTIFICATE

I, James F. Biagi, surveyor, do hereby  
certify that I have surveyed the lands  
hereon described.

December 3, 1971

*James F. Biagi*  
James F. Biagi

R.L.S. 272

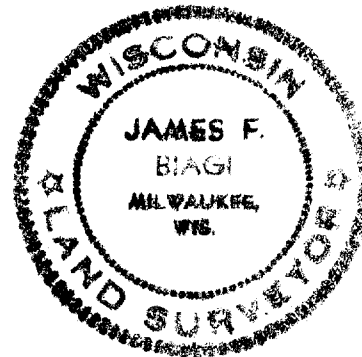

118-93B