


WALWORTH COUNTY
SURVEYING & MAPPING
727 HENRY STREET
LAKE GENEVA, WISCONSIN
414-248-0505

PLAT OF SURVEY OF

LOTS 2964-2971, BLOCK 63 OF SECTION 2 OF PELL LAKE
SUBDIVISION, LOCATED IN SECTION 22, T 1 N, R 18 E,
WALWORTH COUNTY, WISCONSIN.


ORDERED BY: REALTY WORLD-KEITH JOHNSON REALTY
P. O. BOX 727
TWIN LAKES, WISCONSIN
53181

GRAPHIC SCALE

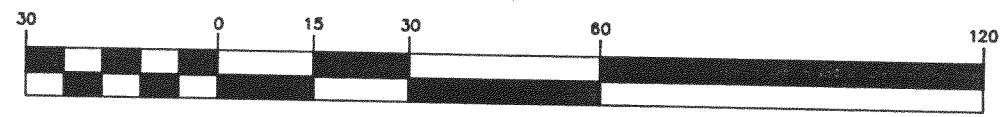

(IN FEET)
1 inch = 30 ft.

- ⊙-IRON PIPE FOUND
- ⊗-IRON ROD FOUND
- ()-RECORDED AS

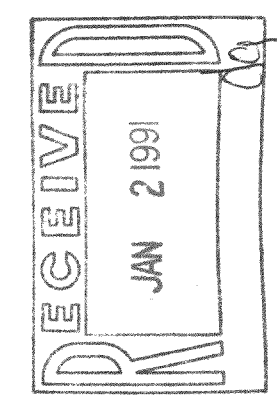

I HEREBY CERTIFY THAT I HAVE SURVEYED THE ABOVE DESCRIBED
PROPERTY AND THAT THE ABOVE MAP IS A TRUE REPRESENTATION
THEREOF AND SHOWS THE SIZE AND LOCATION OF THE PROPERTY,
ITS EXTERIOR BOUNDARIES, THE LOCATION OF ALL VISIBLE STRUCTURES
AND DIMENSIONS OF ALL PRINCIPAL BUILDINGS THEREON, BOUNDARY
FENCES, APPARENT EASEMENTS, ROADWAYS AND VISIBLE ENCROACH-
MENTS, IF ANY, TO THE BEST OF MY KNOWLEDGE AND BELIEF.

THIS SURVEY IS MADE FOR THE USE OF THE PRESENT OWNERS OF
THE PROPERTY AND ALSO THOSE WHO PURCHASE, MORTGAGE OR
GUARANTEE THE TITLE THERETO WITHIN ONE (1) YEAR FROM DATE
HEREOF.

Robert M. Baerenwald
ROBERT M. BAERENWALD
WISCONSIN REGISTERED LAND SURVEYOR, S-1508

DATE Aug. 30, 1990 JOB NO. 2640

NOTE: THIS IS NOT A CERTIFIED COPY UNLESS SEALED.

118-959

MPL 00621