


WALWORTH COUNTY
SURVEYING & MAPPING
LAKE GENEVA, WISCONSIN
414-248-0505

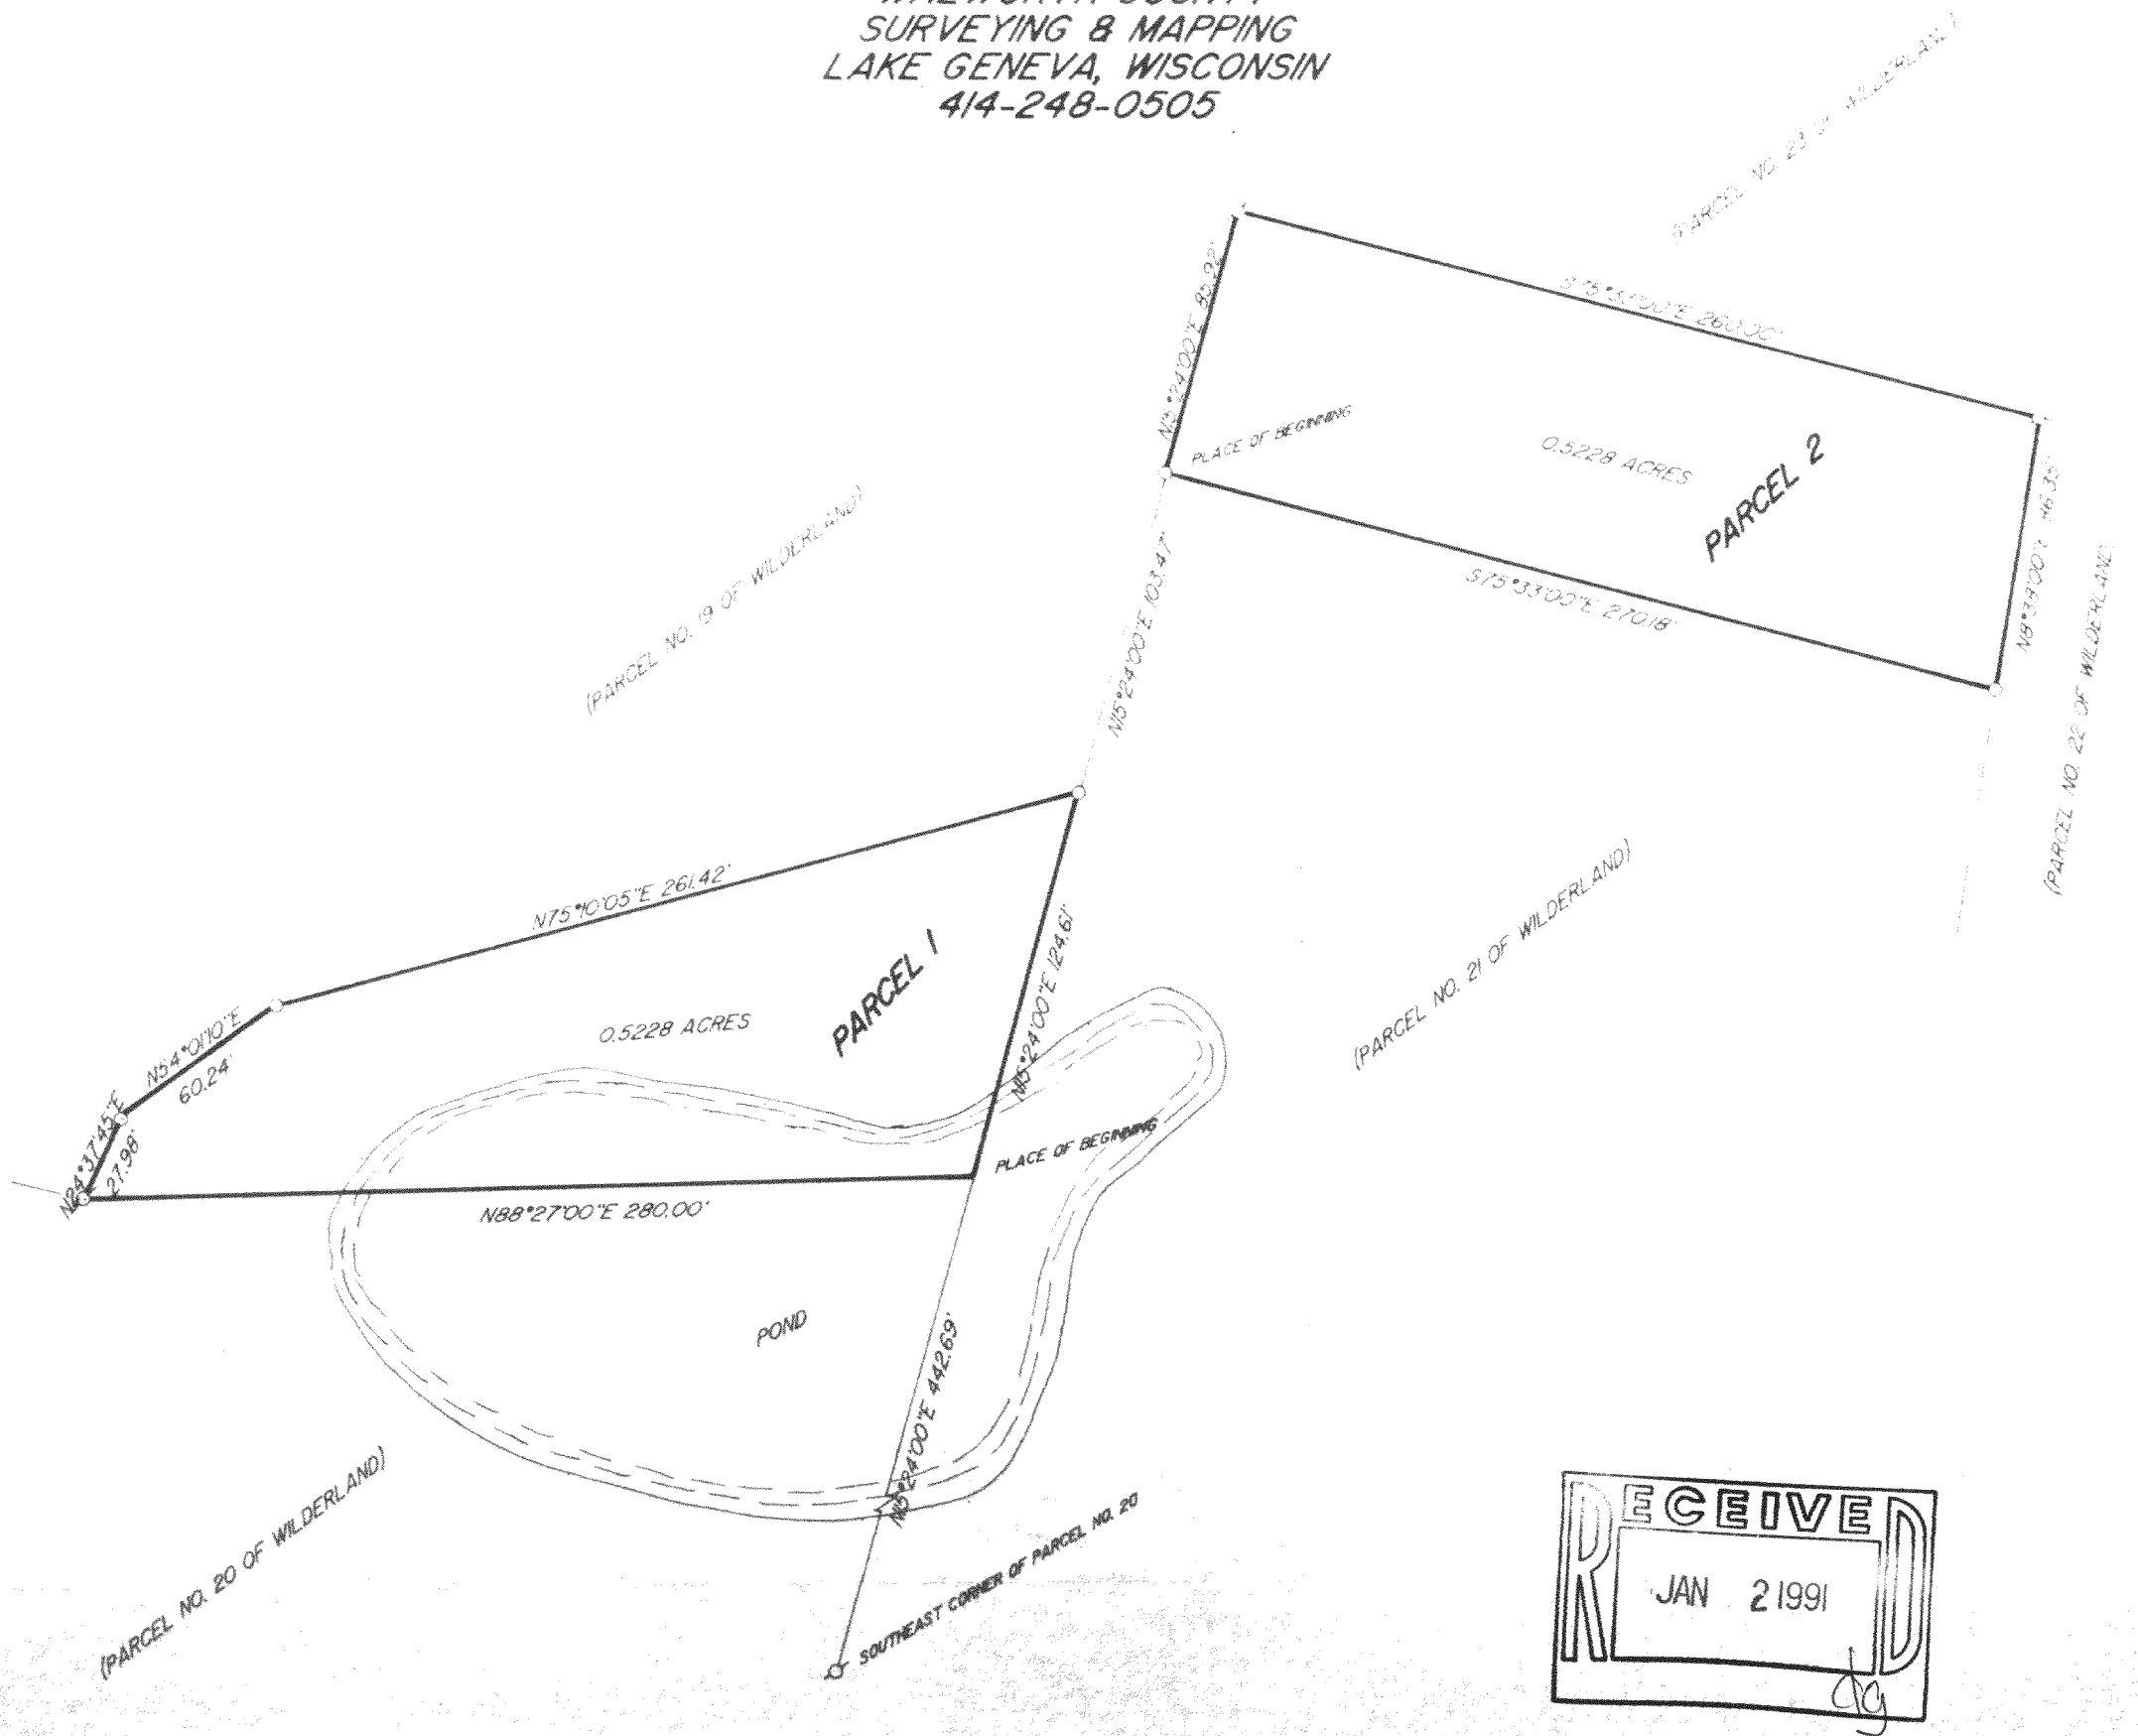

PLAT OF SURVEY OF

PARCEL 1: PART OF PARCEL NO. 19 OF WILDERLAND, AN UNRECORDED SUBDIVISION, DESCRIBED AS FOLLOWS: PART OF THE SOUTHEAST $\frac{1}{4}$ OF THE SOUTHWEST $\frac{1}{4}$ OF SECTION 5, T 1 N, R 18 E, WALWORTH COUNTY, WISCONSIN, DESCRIBED AS FOLLOWS: COMMENCING AT THE SOUTHWEST CORNER OF LOT 1 OF CERTIFIED SURVEY MAP NO. 976 AS RECORDED IN VOLUME 4, PAGE 239 OF CERTIFIED SURVEY MAPS, WALWORTH COUNTY, THENCE S10°48'E 172.00 FEET; THENCE S3°54'30"E 452.85 FEET; THENCE S7°04'W 576.10 FEET; THENCE S86°15'W 262.00 FEET; THENCE S23°49'E 385.61 FEET; THENCE S5°00'W 287.00 FEET; THENCE S20°37'W 215.17 FEET; THENCE S53°04'W 231.69 FEET; THENCE S61°44'W 113.70 FEET; THENCE S30°05'W 318.57 FEET; THENCE S0°46'E 154.49 FEET; THENCE S82°08'W 393.21 FEET; THENCE N86°03'W 99.80 FEET; THENCE N75°17'W 349.78 FEET; THENCE N15°24'00"E 442.69 FEET TO THE PLACE OF BEGINNING; THENCE S88°27'00"W 280.00 FEET; THENCE N24°37'45"E 27.98 FEET; THENCE N54°01'10"E 60.24 FEET; THENCE N75°10'05"E 261.42 FEET; THENCE S15°24'00"W 124.61 FEET TO THE PLACE OF BEGINNING, CONTAINING 0.5228 ACRES OF LAND.

PARCEL 2: PART OF PARCEL NO. 21 OF WILDERLAND, AN UNRECORDED SUBDIVISION, DESCRIBED AS FOLLOWS: PART OF THE SOUTHEAST $\frac{1}{4}$ OF THE SOUTHWEST $\frac{1}{4}$ OF SECTION 5, T 1 N, R 18 E, WALWORTH COUNTY, WISCONSIN, DESCRIBED AS FOLLOWS: COMMENCING AT THE SOUTHWEST CORNER OF LOT 1 OF CERTIFIED SURVEY MAP NO. 976 AS RECORDED IN VOLUME 4, PAGE 239 OF CERTIFIED SURVEY MAPS, WALWORTH COUNTY, THENCE S10°48'E 172.00 FEET; THENCE S3°54'30"E 452.85 FEET; THENCE S7°04'W 576.10 FEET; THENCE S86°15'W 262.00 FEET; THENCE S23°49'E 385.61 FEET; THENCE S5°00'W 287.00 FEET; THENCE S20°37'W 215.17 FEET; THENCE S53°04'W 231.69 FEET; THENCE S61°44'W 113.70 FEET; THENCE S30°05'W 318.57 FEET; THENCE S0°46'E 154.49 FEET; THENCE S82°08'W 393.21 FEET; THENCE N86°03'W 99.80 FEET; THENCE N75°17'W 349.78 FEET; THENCE N15°24'00"E 670.77 FEET TO THE PLACE OF BEGINNING; THENCE N15°24'00"E 85.92 FEET; THENCE S75°33'00"E 260.00 FEET; THENCE S8°38'00"W 86.35 FEET; THENCE N75°33'W 270.18 FEET TO THE PLACE OF BEGINNING, CONTAINING 0.5228 ACRES OF LAND.


ORDERED BY: JOHN BURK
LAKE GENEVA, WISCONSIN

I HEREBY CERTIFY THAT I HAVE SURVEYED THE ABOVE DESCRIBED PROPERTY AND THAT THE ABOVE MAP IS A TRUE REPRESENTATION THEREOF AND SHOWS THE SIZE AND LOCATION OF THE PROPERTY, ITS EXTENT, BOUNDARIES, THE LOCATION OF ALL VISIBLE STRUCTURES AND ENCLOSURES OF ALL ADJACENT LANDS, THE LOCATION OF ALL VISIBLE APPARENT EASEMENTS AND EASEMENTS AND VISIBLE ENCROACHMENTS IF ANY, TO THE BEST OF MY KNOWLEDGE AND BELIEF.

THIS SURVEY IS MADE FOR THE USE OF THE PRESENT OWNERS OF THE PROPERTY AND ALSO THOSE WHO PURCHASE, MORTGAGE OR GUARANTEE THE TITLE THEREIN WITHIN ONE (1) YEAR FROM DATE HEREOF.

Robert M. Baerenwald
ROBERT M. BAERENWALD
WISCONSIN REGISTERED LAND SURVEYOR S-1508
DATE: Nov 8, 1989
JOB NO. 220

MW 00020
MW 00021

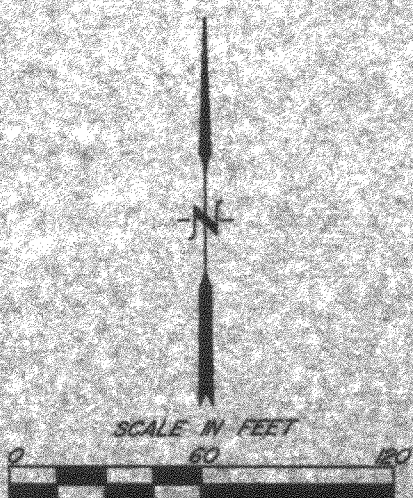

σ - IRON PIPE FOUND
○ - IRON PIPE PLACED

118-963