
(45-31)

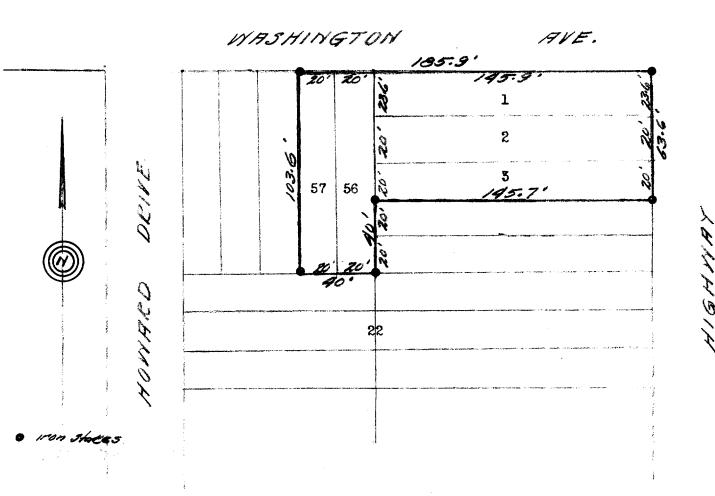

DESCRIPTION:

Lots 1, 2, 3, 56, & 57, Block 22 Lake Ivanhoe Subdivision of a portion of Bloomfield Township, Walworth County Wisconsin.

CERTIFICATE:

I, hereby certify that I have on this the 17th day of November 1945, surveyed the above described property according to the official records on file in the office of the Recorder of Deeds in and for Walworth County Wisconsin, and find that the measurements and bearings taken on this day substantially agree with those in the above description and that no encroachments exist.

SIGNED AND SEALED THIS 22ND DAY OF NOVEMBER 1945.

Joseph M. Biagi.

Professional Engineer.

Elkhorn Wisconsin.