

DESCRIPTION:

Lots 1, 2, 3, 12, & 13 of Block 3 Shimmers 4th Addition Located in Section 24, T.1N., R.18E., lying and being in Bloomfield Township in the County of Walworth and the State of Wisconsin.


CERTIFICATE:

I, James F. Biagi, surveyor, do hereby certify that I have surveyed the property hereon described.

DATE:

June 25, 1971

James F. Biagi
 James F. Biagi
 Elkhorn, Wisconsin

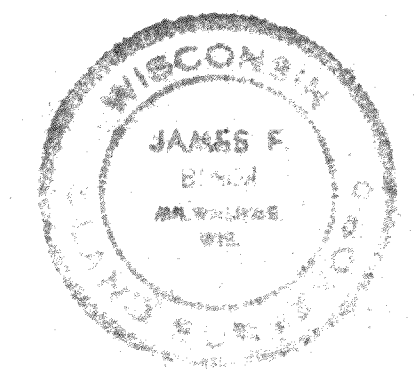

●-INDICATES IRON PIPE FOUND

mnp 54-57, mnp 54-61

REVISIONS			PLAT OF SURVEY FOR		
NO.	DATE	BY	MR. & MRS. CHARLES NAPIER		
1			GENOA CITY, WIS.		
2			DRAWN BY	SCALE	MATERIAL
3			CHK'D	DATE	DRAWING NO.
4			TRACED	APP'D	
5					

118-302-330