

N



SCALE - 1" = 20'  
O = IRON PIPE


THISTLE DRIVE

PRIMROSE ROAD

ROAD

FENCE CORNER IS 4.9'E & 5.8' N OF PROP. COR.

FENCE CORNER IS 1.1'E AND 5.1' N OF PROP. COR.

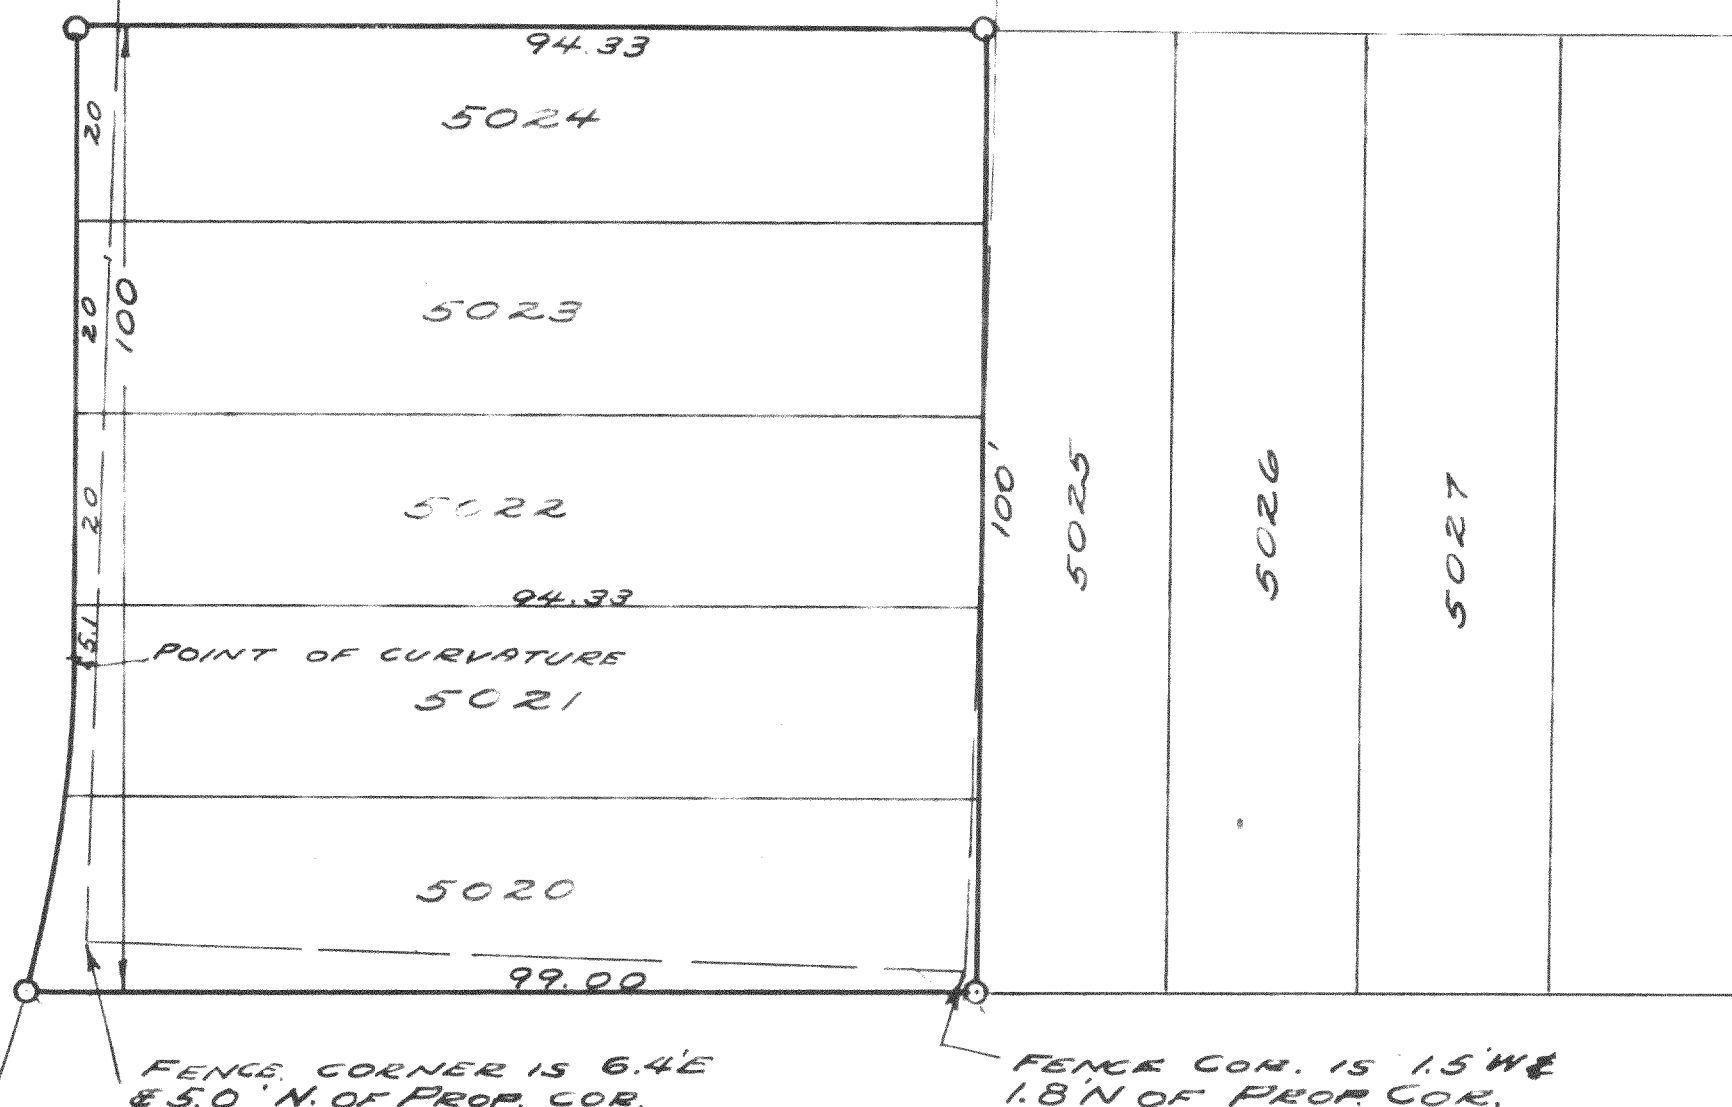

FENCE CORNER IS 6.4'E & 5.0' N OF PROP. COR.

FENCE COR. IS 1.5' W & 1.8' N OF PROP. COR.

PLAT OF SURVEY OF LOTS 5020 TO 5024 <sup>inclusive</sup> OF SECTION 3 OF PELL LAKE, S. T1N R1E OF WALWORTH COUNTY, WISCONSIN.

SEPT., 1946

*H. E. Johnson*  
SURVEYOR