

PLAT OF SURVEY  
OF

LOTS 9718 THRU 9727 IN BLOCK 214 OF SECTION 7 OF PELL LAKE, A SUBDIVISION LOCATED IN SECTION 21, T. 1 N., R. 18 E. OF THE 4TH P.M., TOWNSHIP OF BLOOMFIELD, COUNTY OF WALWORTH, WISCONSIN.

FOR: HAZEL ZARNSTORFF (1980)

LOIS FORBES (1992)



SCALE 1" = 50'

∅ = IRO N PIPE STAKE FOUND.

○ = IRON PIPE STAKE SET.

I HEREBY CERTIFY THAT THE LAND DESCRIBED ABOVE WAS SURVEYED UNDER MY DIRECTION AND THAT THE PLAT DRAWN HEREON IS A CORRECT REPRESENTATION OF SAID SURVEY.

*John F. Degen* 3-28-80  
 JOHN F. DEGEN, LAND SURVEYOR #242  
 589 N. PINE ST., BURLINGTON, WISCONSIN.  
 RESURVEYED MARCH 10, 1992.

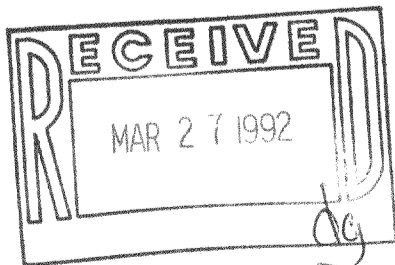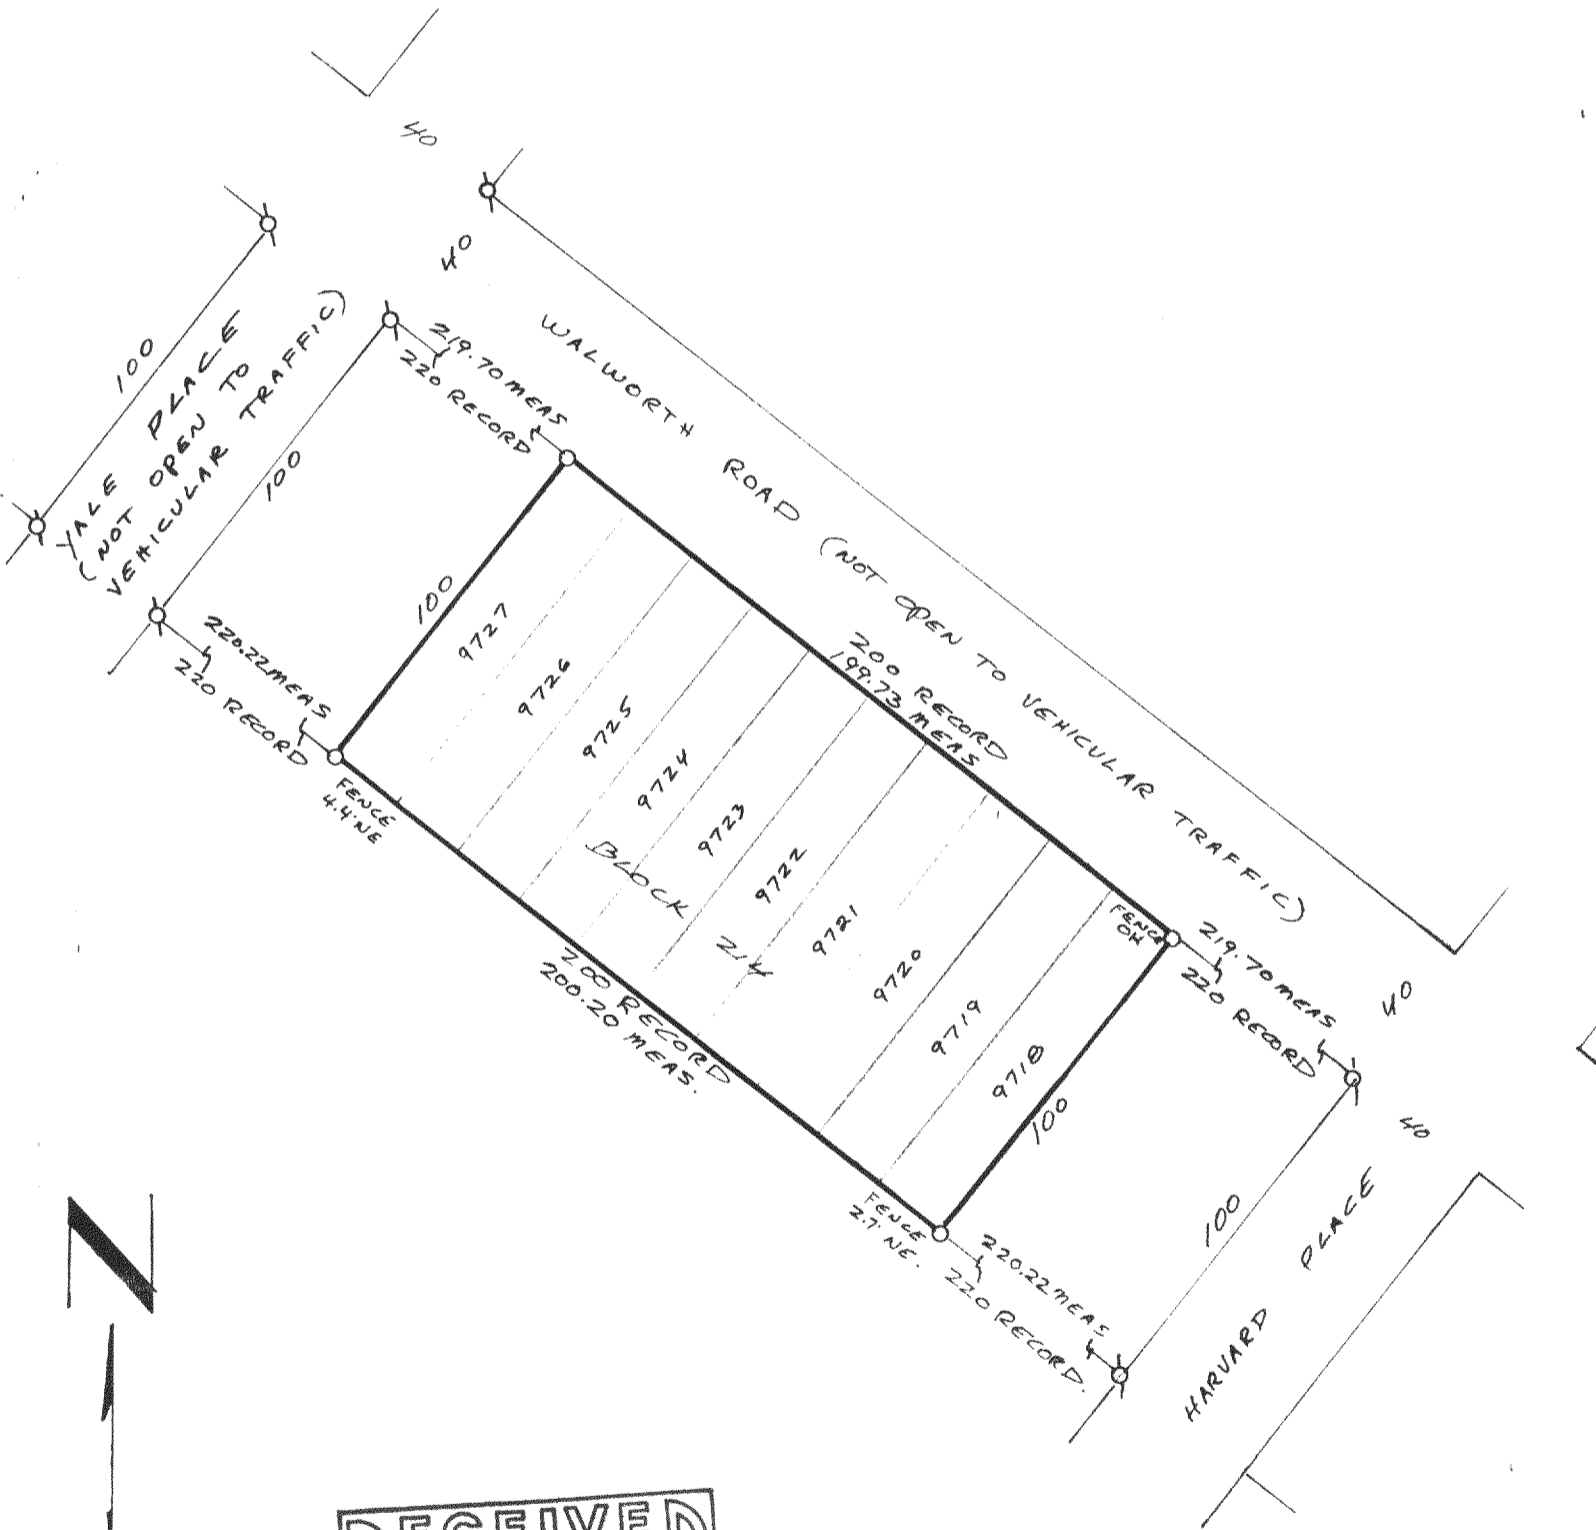

ST 12-A #45  
118-1028

MPL 01970  
MPL 01971