


KOLB LAND CONSULTING, INC.
 LAND SURVEYING · SUBDIVIDING · LAND PLANNING

928 WILLIAMS STREET LAKE GENEVA, WISCONSIN 53147 414-248-3697

FAIRVIEW ROAD 40' WIDE

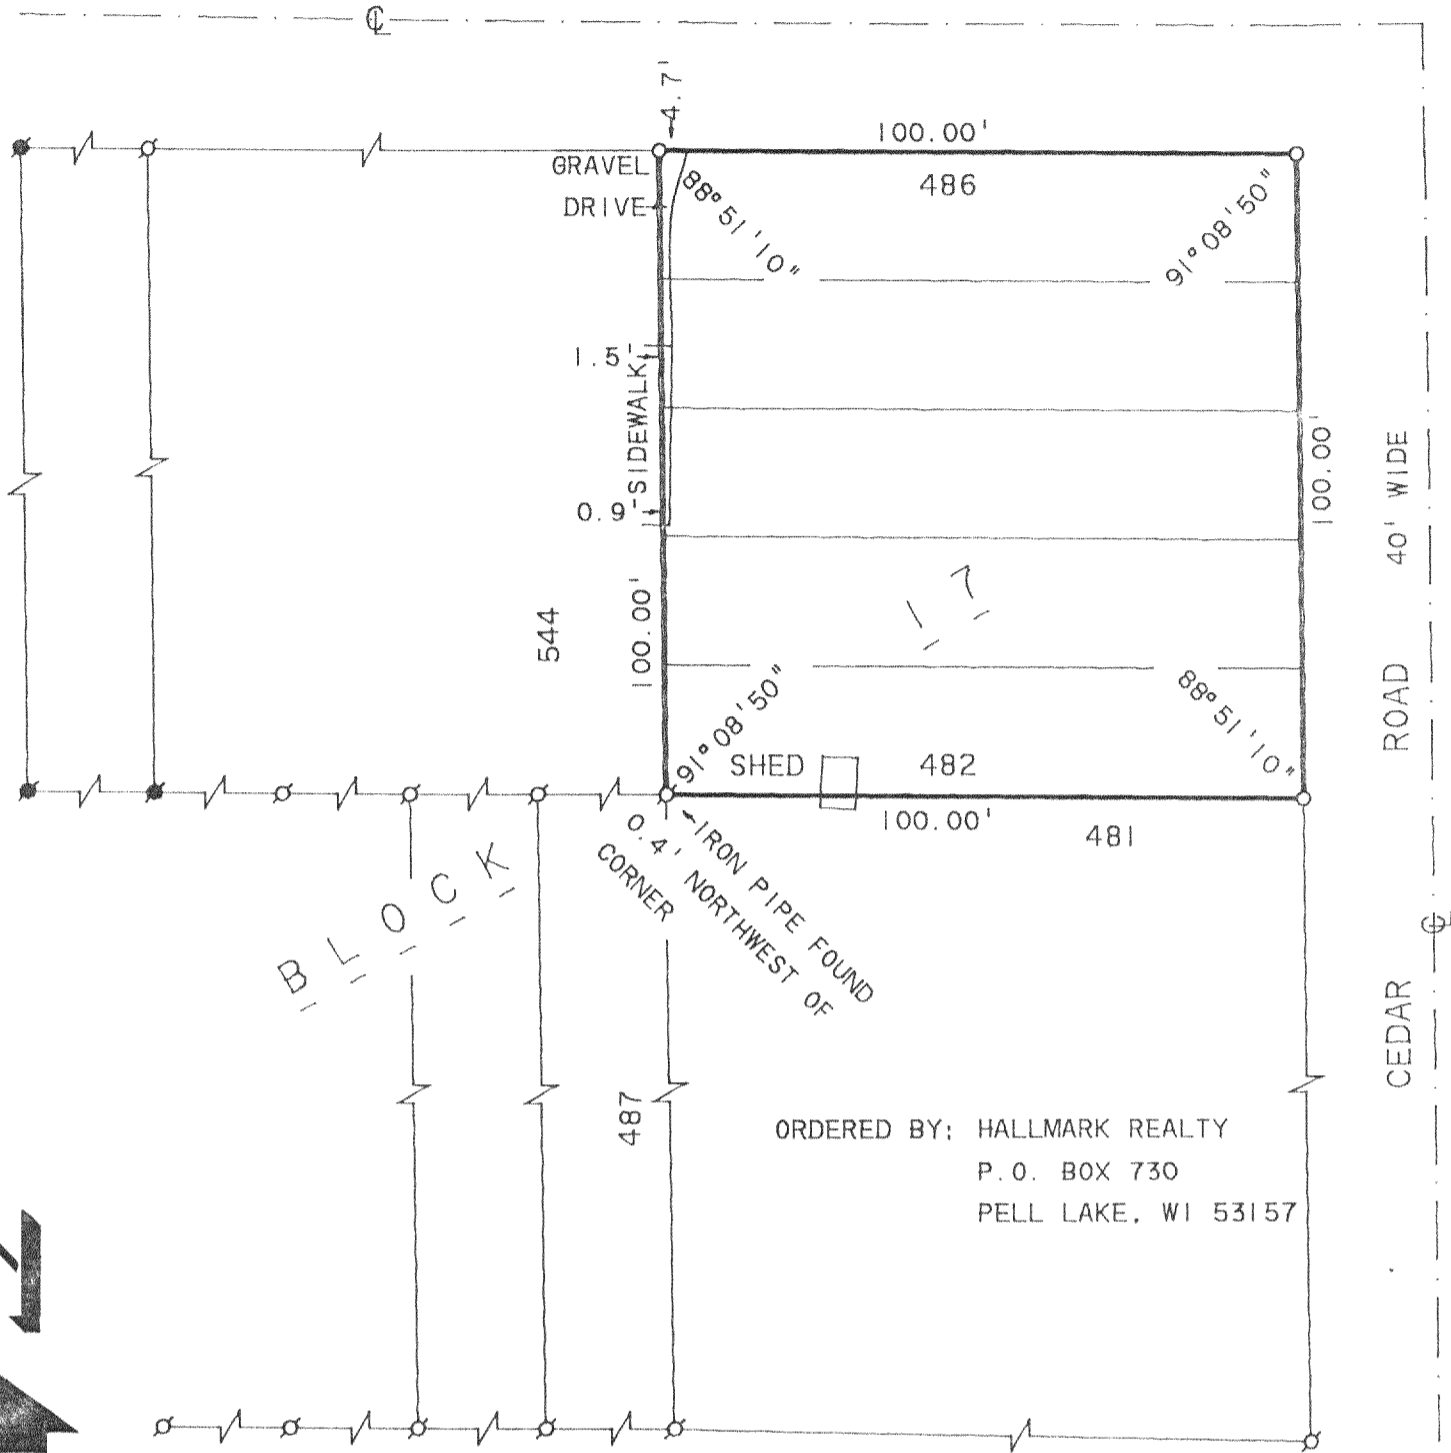

ORDERED BY: HALLMARK REALTY
 P.O. BOX 730
 PELL LAKE, WI 53157

SCALE 1" = 30'

LEGEND


- ⊙ - IRON PIPE FOUND
- - IRON ROD FOUND
- - IRON PIPE SET

PLAT OF SURVEY OF

LOTS 482-486, BLOCK 17, PELL LAKE HIGHLANDS
 SUBDIVISION, LOCATED IN THE TOWN OF BLOOMFIELD
 WALWORTH COUNTY, WISCONSIN.

I HEREBY CERTIFY THAT I HAVE SURVEYED THE ABOVE
 DESCRIBED PROPERTY AND THAT THE ABOVE MAP IS A
 TRUE REPRESENTATION THEREOF AND SHOWS THE SIZE
 AND LOCATION OF THE PROPERTY, ITS EXTERIOR
 BOUNDARIES, THE LOCATION OF ALL VISIBLE STRUCTURES
 AND THE DIMENSIONS OF ALL PRINCIPAL BUILDINGS
 THEREON, BOUNDARY FENCES, APPARENT EASEMENTS,
 ROADWAYS AND VISIBLE ENCROACHMENTS, IF ANY, TO THE
 BEST OF MY KNOWLEDGE AND BELIEF.
 THIS SURVEY IS MADE FOR THE USE OF THE PRESENT
 OWNERS OF THE PROPERTY, AND ALSO THOSE WHO PURCHASE,
 MORTGAGE, OR GUARANTEE THE TITLE THERETO WITHIN
 ONE (1) YEAR FROM DATE HEREON.

THIS SURVEY IS NOT VALID UNLESS THE SURVEYOR'S
 SIGNATURE IS IN RED.

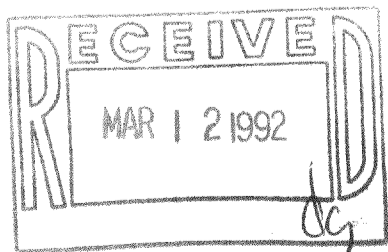

HAROLD H. KOLB
 WISCONSIN REGISTERED LAND SURVEYOR, S-187
 DATE JUNE 28, 1990
 REVISED _____