
## KOLB LAND CONSULTING, INC.

SHEDS

89°26'10"

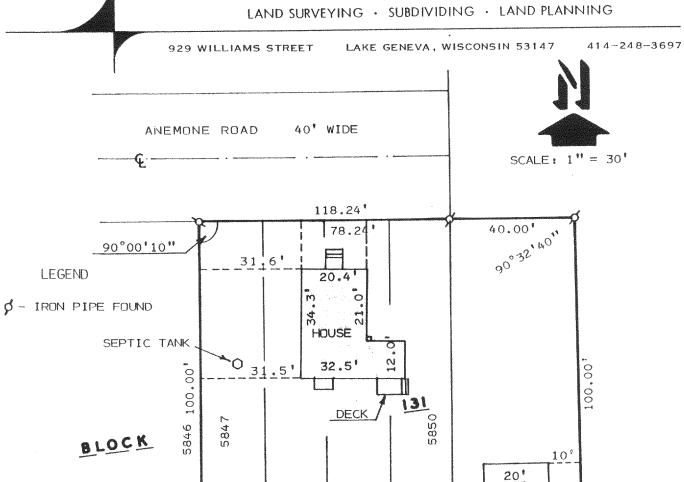

79 12' 119.12

PLAT OF SURVEY OF

SEPTIC TANK -

A PROPOSED STORAGE BUILDING LOCATION ON LOTS 5847-5850, BLOCK 131 OF PELL LAKE SUBDIVISION AND A PARCEL OF LAND LOCATED IN THE NORTHEAST 1/4 OF SECTION 15, ALL IN T1N, R18E, TOWN OF BLOOMFIELD, WAL-WORTH COUNTY, WISCONSIN.

90°01'00"

ORDERED BY: MARGRET JENKINS 5343 S. SACREMENTO CHICAGO, IL. 60629



I, HAROLD H. KOLB, DO HEREBY CERTIFY THAT I HAVE SURVEYED THE PROPERTY HEREON DESCRIBED ACCORDING TO THE OFFICIAL RECORDS AND THAT THE PLAT HEREON IS A CORRECT REPRESENTATION OF THE LOT LINES TO THE BEST OF MY KNOWLEDGE AND BELIEF. SURVEY NOT VALID UNLESS SURVEYOR'S SIGNATURE IS IN RED.

HAROL	D	Н.	K	Ol	 В	
HARUL	U	п.	1	U	 D	

WISCONSIN REGISTERED LAND SURVEYOR, S-187 DATE AUGUST 20, 1991

REVISED\_

REVISED\_

PROPOSED

STORAGE

BUILDING