



**WALWORTH COUNTY  
SURVEYING & MAPPING**  
727 HENRY STREET  
LAKE GENEVA, WISCONSIN  
414-248-0505

MULBERRY DRIVE

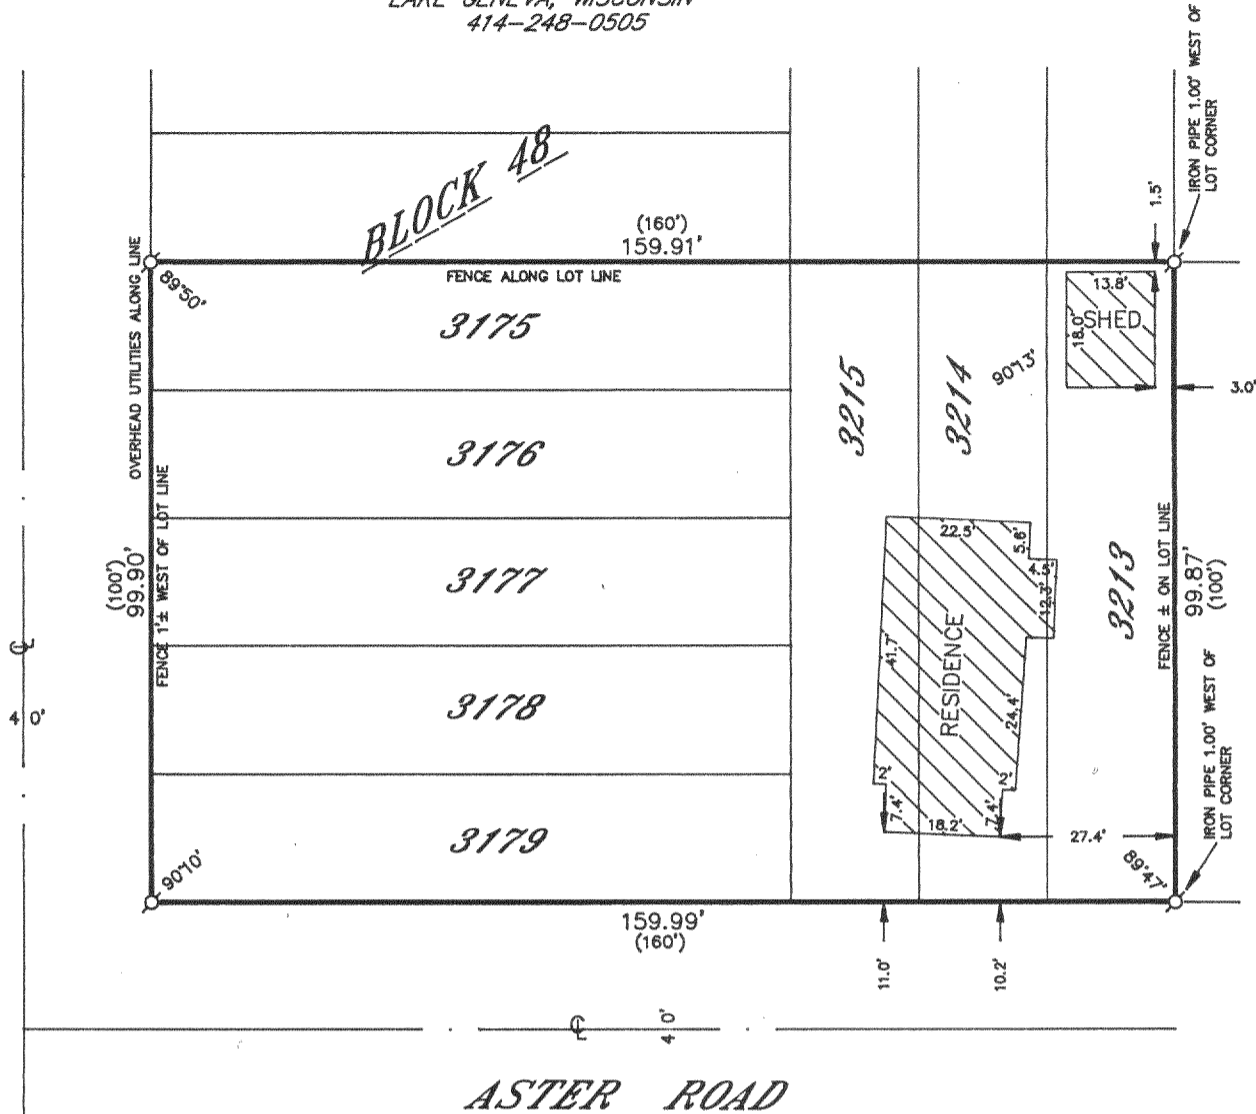

ASTER ROAD

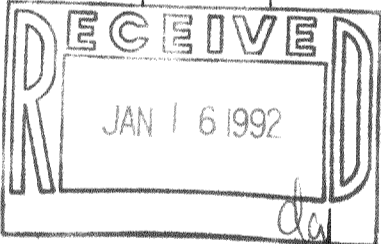

PLAT OF SURVEY OF

LOTS 3175-3179 AND LOTS 3213-3215, AS DESIGNATED AND DELINEATED ON THE MAP ENTITLED "MAP OF SECTION "TWO" OF PELL LAKE, WALWORTH COUNTY, WISCONSIN", AND RECORDED IN THE OFFICE OF THE REGISTER OF DEEDS IN AND FOR THE COUNTY OF WALWORTH AND STATE OF WISCONSIN ON THE 16TH DAY OF JULY, 1924.

ORDERED BY: REALTY WORLD-KEITH JOHNSON  
P. O. BOX 727  
TWIN LAKES, WISCONSIN  
53181


I HEREBY CERTIFY THAT I HAVE SURVEYED THE ABOVE DESCRIBED PROPERTY AND THAT THE ABOVE MAP IS A TRUE REPRESENTATION THEREOF AND SHOWS THE SIZE AND LOCATION OF THE PROPERTY, ITS EXTERIOR BOUNDARIES, THE LOCATION OF ALL VISIBLE STRUCTURES AND DIMENSIONS OF ALL PRINCIPAL BUILDINGS THEREON, BOUNDARY FENCES, APPARENT EASEMENTS, ROADWAYS AND VISIBLE ENCROACHMENTS, IF ANY, TO THE BEST OF MY KNOWLEDGE AND BELIEF.

THIS SURVEY IS MADE FOR THE USE OF THE PRESENT OWNERS OF THE PROPERTY AND ALSO THOSE WHO PURCHASE, MORTGAGE OR GUARANTEE THE TITLE THERETO WITHIN ONE (1) YEAR FROM DATE HEREOF.

*Robert M. Baerenwald*  
ROBERT M. BAERENWALD  
WISCONSIN REGISTERED LAND SURVEYOR, S-1508

DATE Oct. 13, 1990 JOB NO. 2718

NOTE: THIS IS NOT A CERTIFIED COPY UNLESS SEALED.

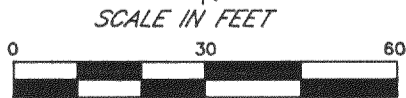

LEGEND  
 ○-IRON PIPE FOUND  
 □-IRON ROD FOUND  
 ■-CONCRETE MONUMENT FOUND  
 ○-IRON PIPE PLACED  
 ( )-RECORDED AS