


HAROLD H. KOLB
REGISTERED PROFESSIONAL LAND SURVEYOR
LAKE GENEVA, WISCONSIN



Scale 1" = 50'

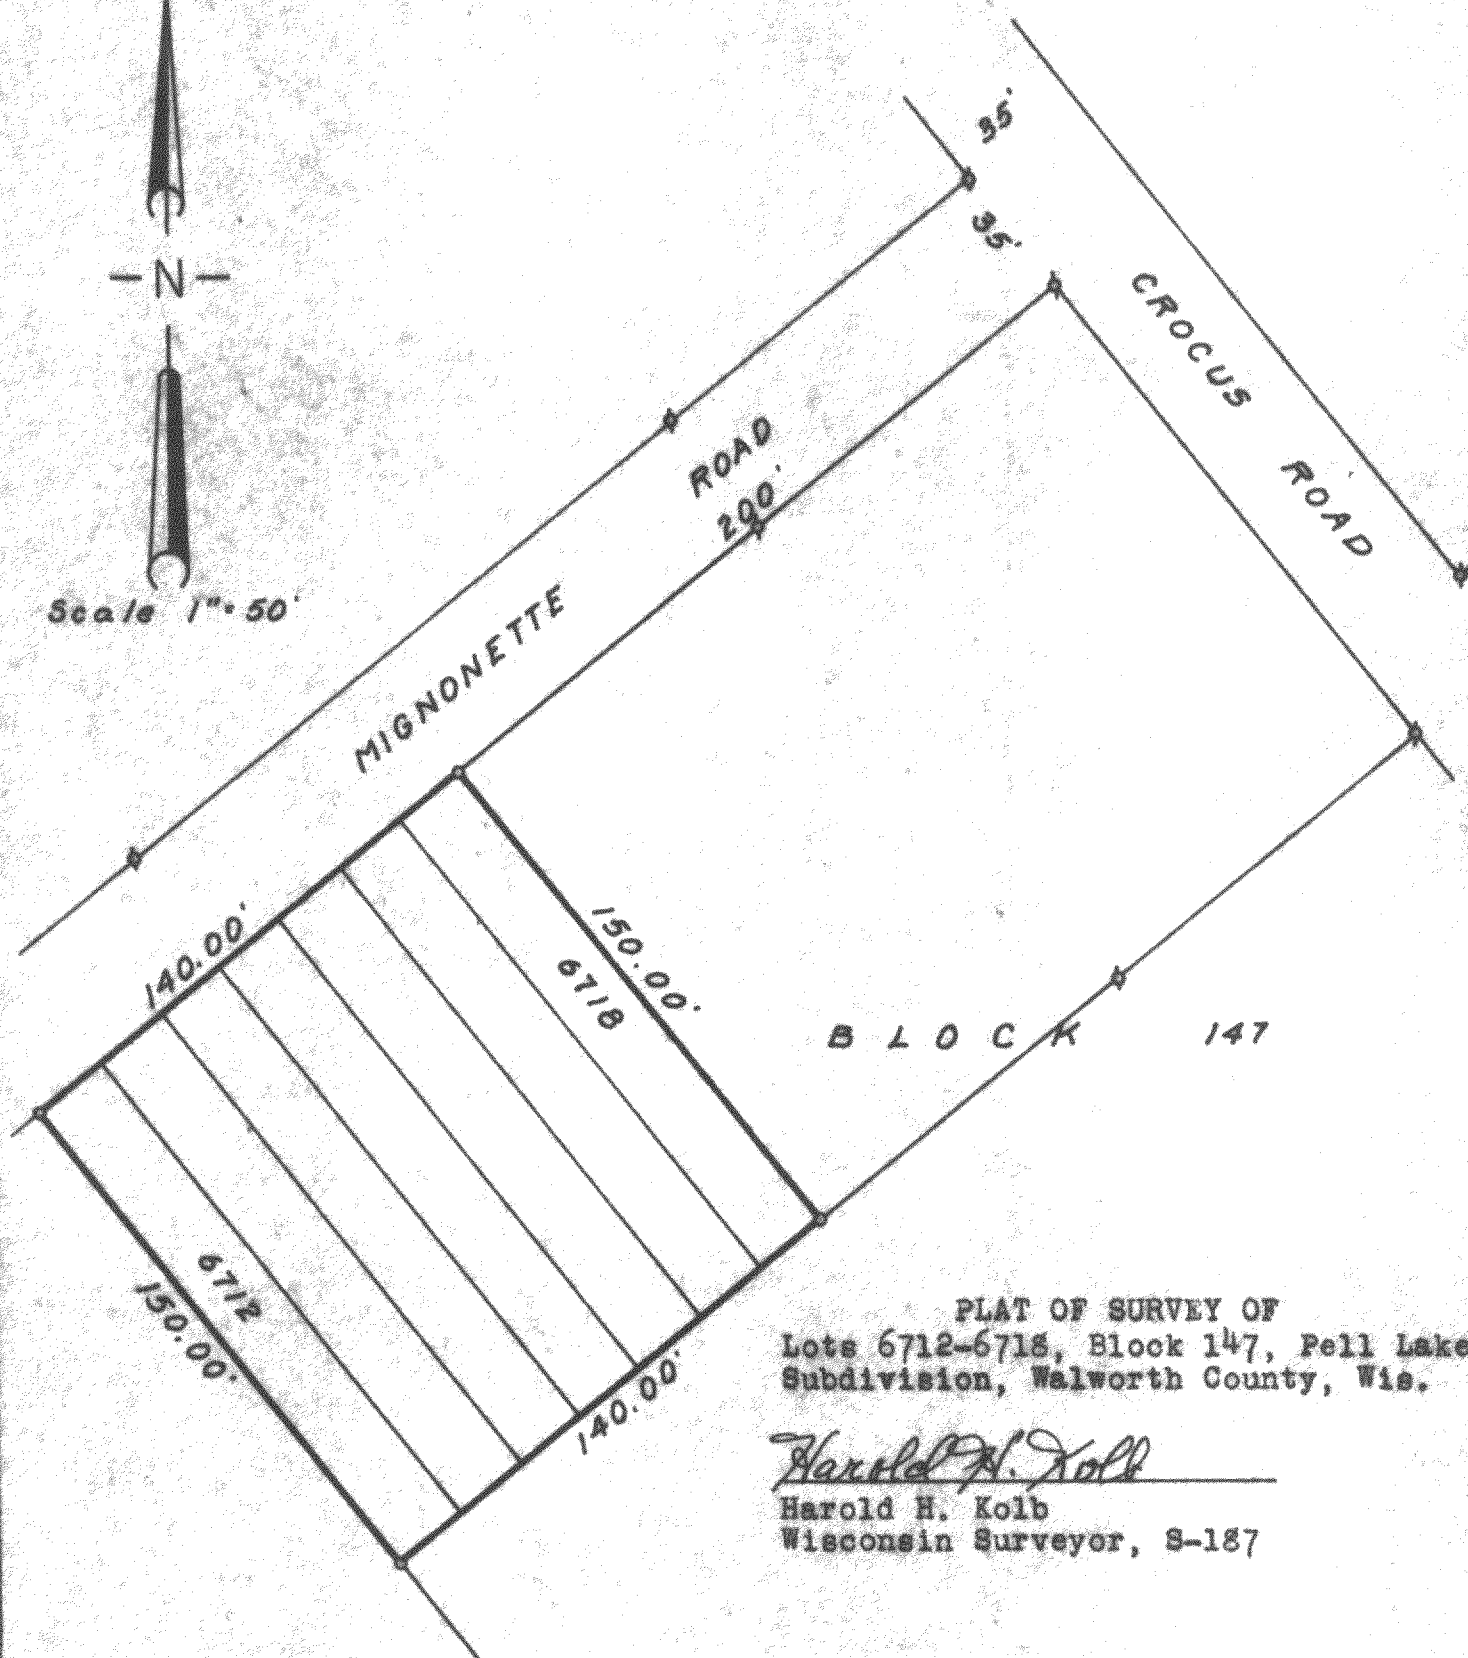

PLAT OF SURVEY OF
Lots 6712-6718, Block 147, Pell Lake
Subdivision, Walworth County, Wis.

Harold H. Kolb

Harold H. Kolb
Wisconsin Surveyor, S-187

• - Iron Pipe Found
• - Iron Pipe Placed
Oct. 1962

118-111

1-18-33