



928 WILLIAMS STREET LAKE GENEVA, WISCONSIN 53147 414-248-3887

928 WILLIAMS STREET LAKE GENEVA, WISCONSIN 53147 414-248-3887

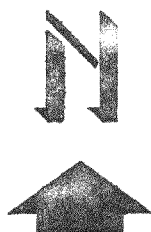

### LEGEND

1236  
61.82' (63.44')

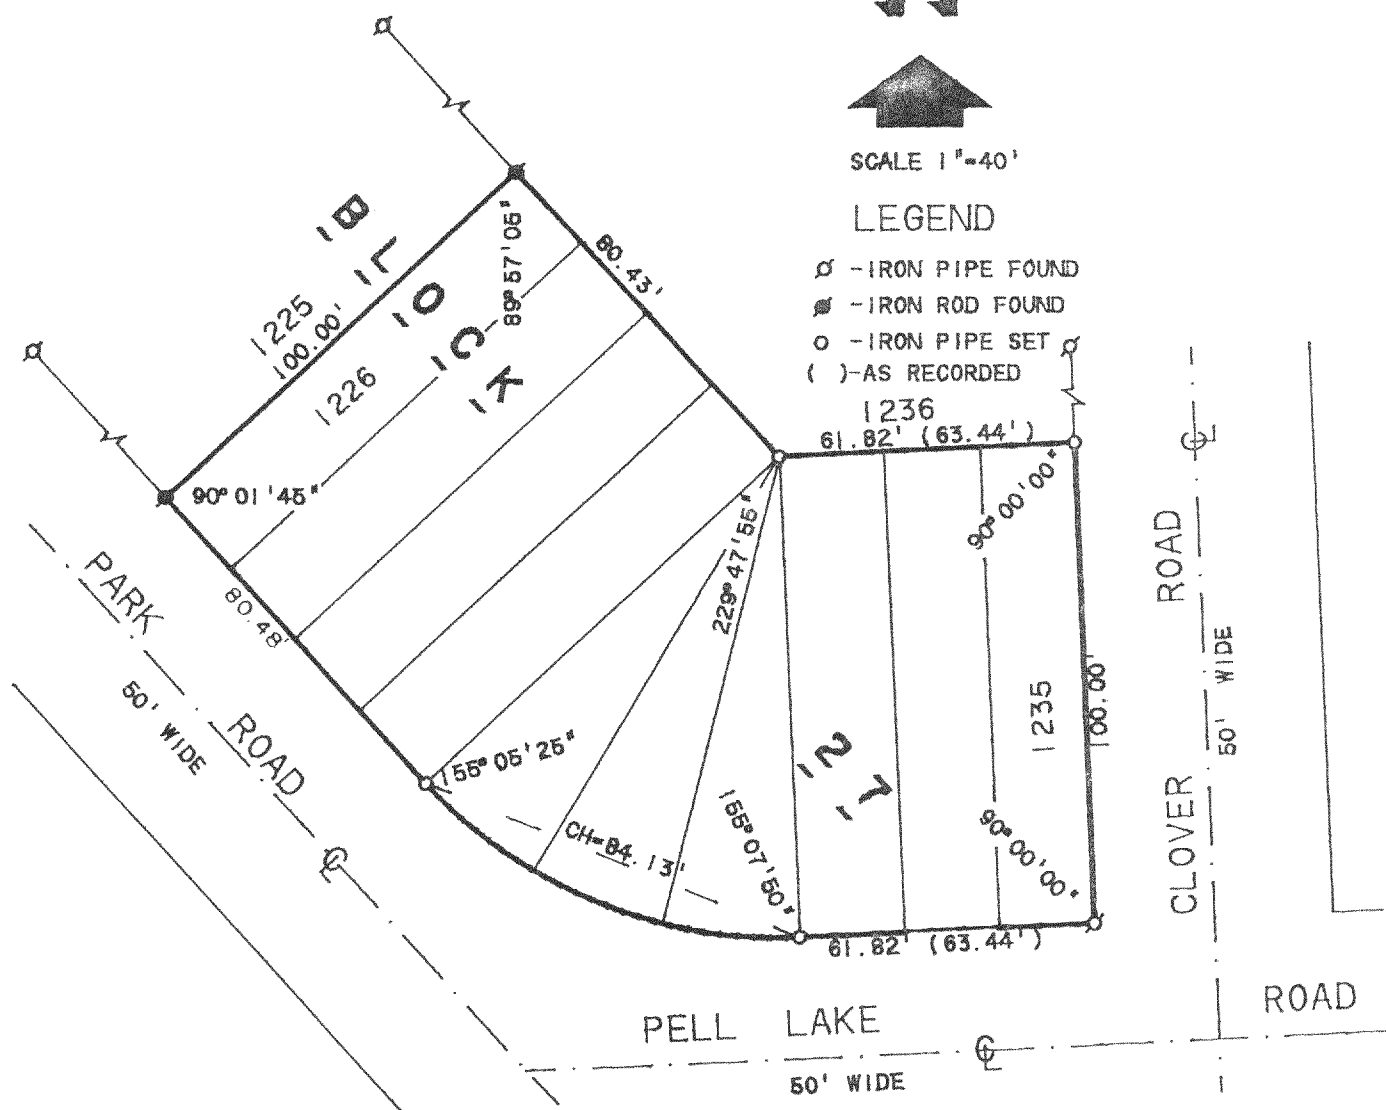

LOTS 1226-1235, BLOCK 27 OF PELL LAKE SUBDIVISION,  
TOWN OF BLOOMFIELD, WALWORTH COUNTY, WISCONSIN.

I, HAROLD H. KOLB, DO HEREBY CERTIFY THAT I HAVE SURVEYED THE PROPERTY HEREON DESCRIBED ACCORDING TO THE OFFICAL RECORDS, AND THAT THE PLAT HEREON IS A CORRECT REPRESENTATION OF THE LOT LINES TO THE BEST OF MY KNOWLEDGE AND BELIEF.

HAROLD H. KOLB

WISCONSIN REGISTERED LAND SURVEYOR, S-187

DATE MAY 31. 1990

REVISED

REVISED

