


KOLB LAND CONSULTING, INC.
LAND SURVEYING • SUBDIVIDING • LAND PLANNING

929 WILLIAMS STREET

LAKE GENEVA, WISCONSIN 53147

414-248-3697

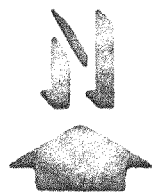

SCALE: 1" = 50'

LEGEND

- o - IRON PIPE SET
x - IRON PIPE FOUND
H - HOUSE

LIST OF FIELD ANGLES


- A) 90°01'15"
B) 89°58'45"
C) 270°01'15"
D) 89°58'45"
E) 90°01'15"
F) 89°58'45"
G) 270°01'15"
H) 89°58'45"

PLAT OF SURVEY OF

LOTS 5928-5930 AND LOTS 5964-5966,
BLOCK 133 OF PELL LAKE SUBDIVISION,
TOWN OF BLOOMFIELD, WALWORTH COUNTY,
WISCONSIN.

ORDERED BY: DOROTHY BAINE

3031 N. MAJOR
CHICAGO, IL. 60634

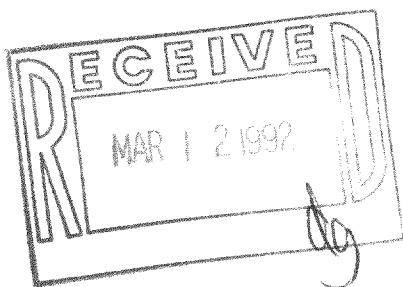

I, HAROLD H. KOLB, DO HEREBY CERTIFY
THAT I HAVE SURVEYED THE PROPERTY
HEREON DESCRIBED ACCORDING TO THE
OFFICIAL RECORDS AND THAT THE PLAT
HEREON IS A CORRECT REPRESENTATION
OF THE LOT LINES AND PRINCIPAL LINES
OF THE BUILDINGS, TO THE BEST OF MY
KNOWLEDGE AND BELIEF.

NOTE: SURVEY NOT VALID UNLESS SURVEYOR'S
SIGNATURE IS IN RED.

HAROLD H. KOLB


WISCONSIN REGISTERED LAND SURVEYOR, S-187

DATE DECEMBER 4, 1990

REVISED

REVISED

MARGUERITE ROAD 40' WIDE

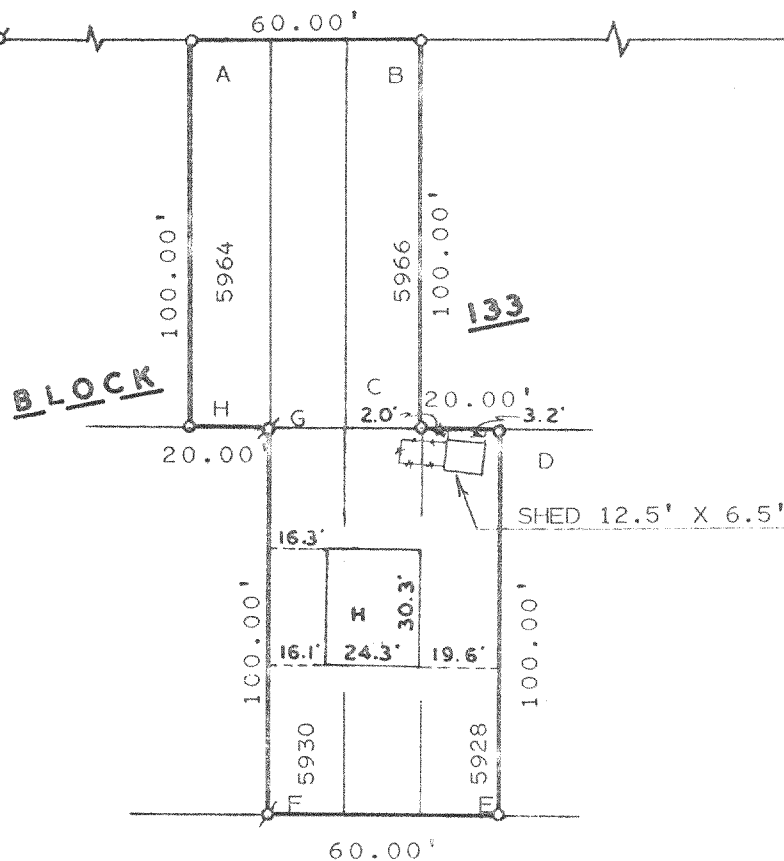

LARKSPUR ROAD 40' WIDE