


HAROLD H. KOLB
REGISTERED PROFESSIONAL LAND SURVEYOR
LAKE GENEVA, WISCONSIN

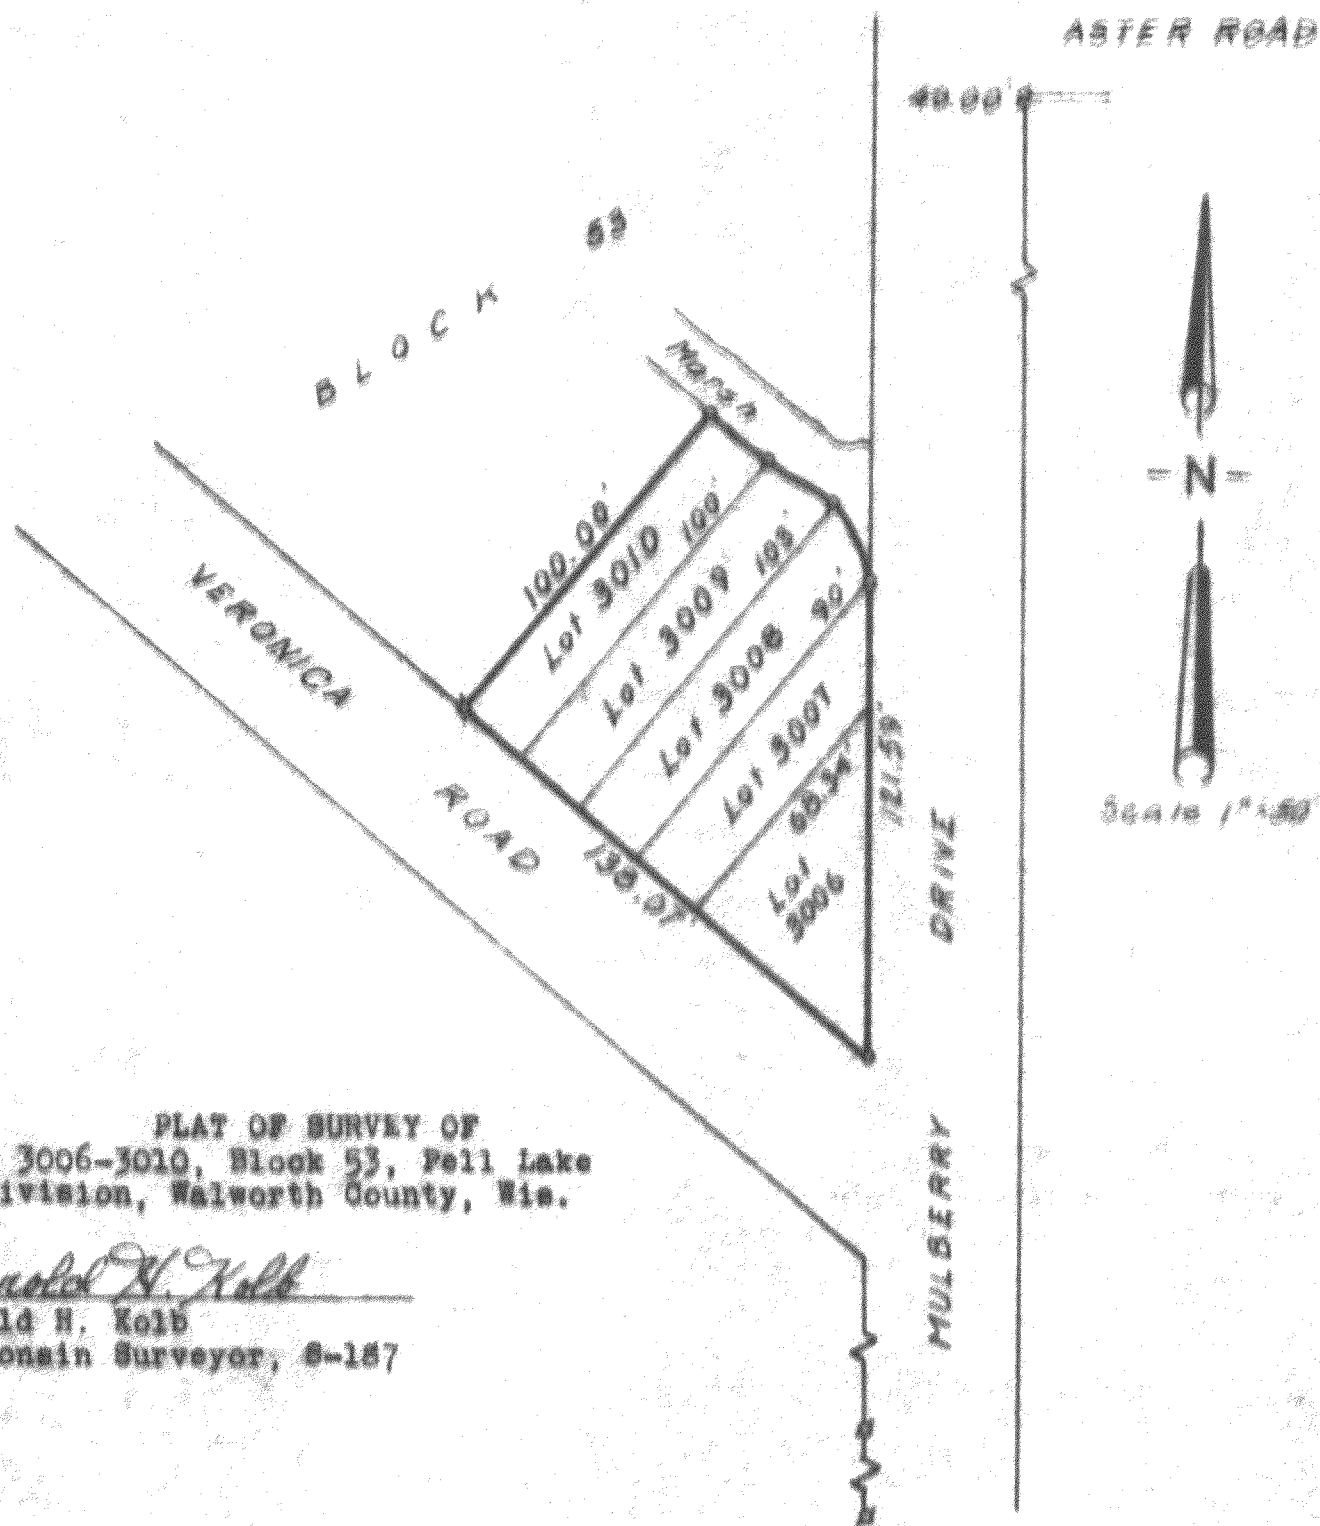

PLAT OF SURVEY OF
Lots 3006-3010, Block 53, Fell Lake
Subdivision, Walworth County, Wis.

Harold H. Kolb
Harold H. Kolb
Wisconsin Surveyor, S-187

⊙ - Iron Pipe Found
⊙ - Iron Pipe Placed
October, 1962

⊕

118-112