


LOTS 1 & 3, LAKE GROVE SUBDIVISION, LOCATED IN THE SOUTHEAST 1/4 OF SECTION 13, T. 1 N., R. 18 E. OF THE 4TH P.M., TOWNSHIP OF BLOOMFIELD, COUNTY OF WALWORTH, STATE OF WISCONSIN.

I HEREBY CERTIFY THAT I HAVE SURVEYED THE LAND DESCRIBED ABOVE AND THAT THE PLAT DRAWN HEREON IS A CORRECT REPRESENTATION OF SAID SURVEY.

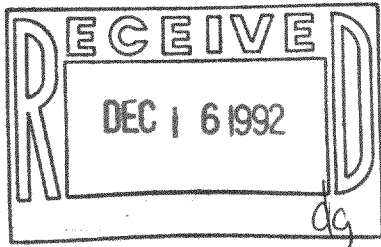

John F. Degen 6-20-75  
 JOHN F. DEGEN, LAND SURVEYOR #242  
 589 N. PINE ST., BURLINGTON, WISCONSIN.  
 REVISED 11-11-92 TO SHOW BUILDING.

SCALE 1" = 30'  
 FOR: MASCOLINO

o = IRON PIPE STAKE UNLESS OTHERWISE NOTED.

BEARING ARE THOSE OF RECORDED PLAT.

E = ELEVATION RELATIVE TO POWER LAKE LEVEL. LAKE

LOT 5 LEVEL ON 6-20-75 was E 50.00 ASSUMED.

BLK 2 LOTS 1 AND 3 ARE VACANT.

JEFFERSON ISLAND

SHED

LOT 6

DWELLING

NOTE: RECORDED PLAT OF LAKE GROVE SUBDIVISION CALL FOR LOT 1 TO BE 105.6 FEET FROM CENTER LINE OF ROAD. LOT IS SUBJECT TO RIGHTS OF PUBLIC FOR HIGHWAY.

