
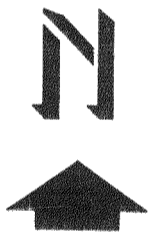


**ABELL  
SURVEYING & MAPPING**

DELAVAN, WISCONSIN 53115  
414-728-6737

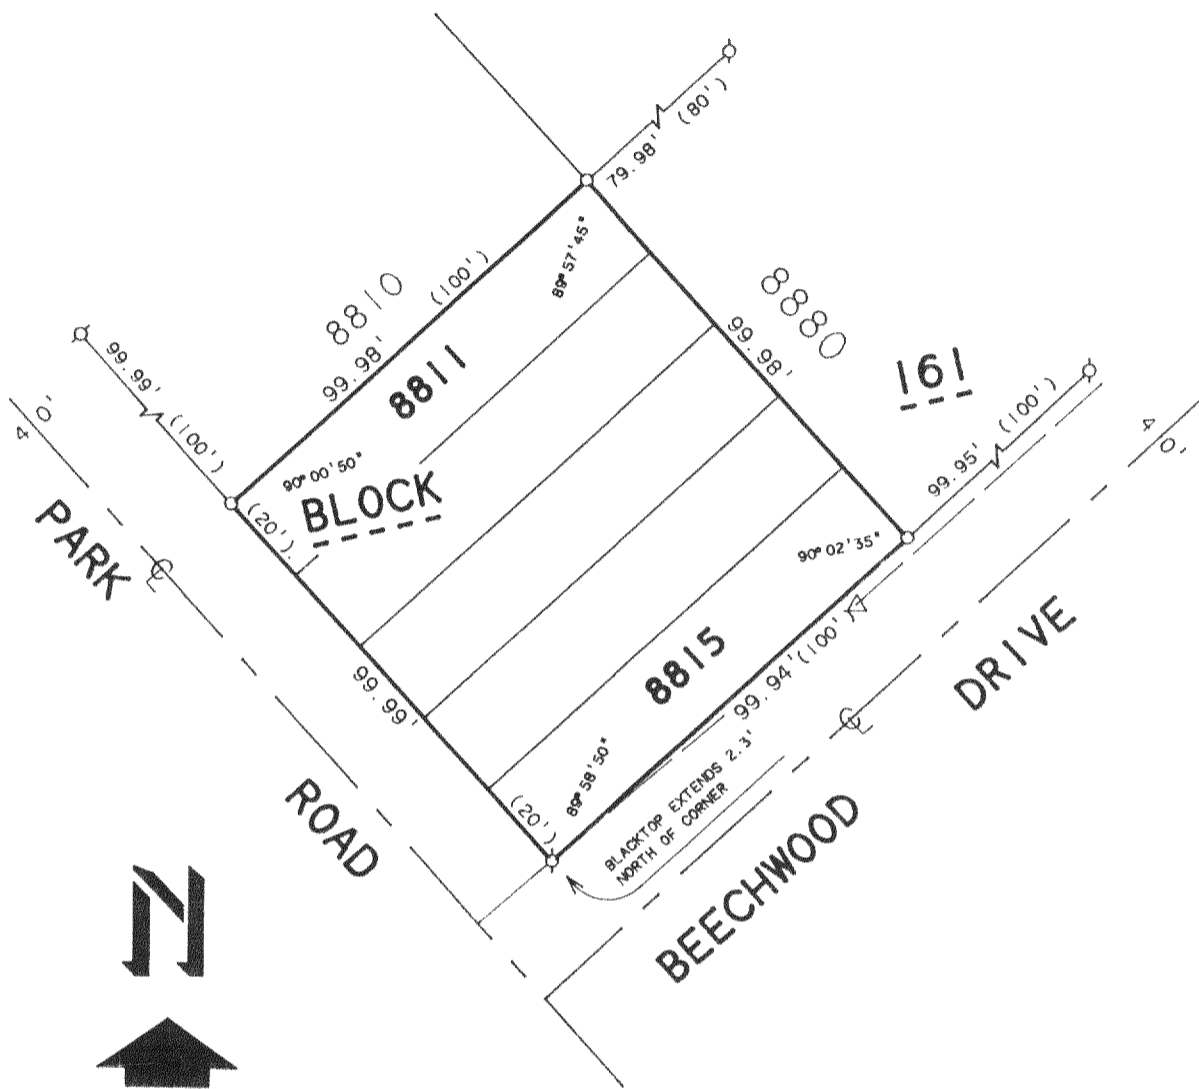


SCALE 1"=40'

LEGEND

- ⊙ - IRON PIPE FOUND
- - IRON PIPE SET
- △ - UTILITY POLE
- - OVERHEAD UTILITY LINE
- ( ) - RECORDED AS

**PLAT OF SURVEY OF**

LOTS 8811 - 8815, BLOCK 161 OF PELL LAKE  
SUBDIVISION, LOCATED IN TIN. RIBE, WALWORTH  
COUNTY, WISCONSIN.

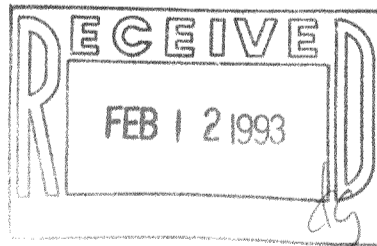

I HEREBY CERTIFY THAT I HAVE SURVEYED THE ABOVE DESCRIBED PROPERTY AND THAT THE ABOVE MAP IS A TRUE REPRESENTATION THEREOF AND SHOWS THE SIZE AND LOCATION OF THE PROPERTY, ITS EXTERIOR BOUNDARIES, THE LOCATION OF ALL VISIBLE STRUCTURES AND DIMENSIONS OF ALL PRINCIPAL BUILDINGS THEREON, BOUNDARY FENCES, APPARENT EASEMENTS, ROADWAYS AND VISIBLE ENCROACHMENTS, IF ANY, TO THE BEST OF MY KNOWLEDGE AND BELIEF.

THIS SURVEY IS MADE FOR THE USE OF THE PRESENT OWNERS OF THE PROPERTY, AND ALSO THOSE WHO PURCHASE, MORTGAGE, OR GUARANTEE THE TITLE THERETO WITHIN ONE (1) YEAR FROM DATE HEREON.

*David F. Abell*

DAVID F. ABELL  
WISCONSIN REGISTERED LAND SURVEYOR, S-1596

ORDERED BY JOHN ARNOW  
35033 INDIAN TRAIL RD.  
INGLESIDE, IL 60041

*November 2, 1992*

DATE: \_\_\_\_\_ JOB NUMBER - 91143  
NOTE: THIS IS NOT A CERTIFIED COPY UNLESS SEALED.

MPL-1771

118-1169