

PLAT OF SURVEY
OF

LOTS 4694 THRU 4697 IN BLK. 91 OF SECTION 3 OF PELL LAKE, A SUBDIVISION LOCATED IN THE SOUTHEAST 1/4 OF SECTION 15, T. 1 N.
R. 18 E. OF THE 4TH P.M., TOWNSHIP OF BLOOMFIELD, COUNTY OF WALWORTH, STATE OF WISCONSIN.


FOR: REALTY WORLD JOHNSON

SCALE 1" = 20'

◊ = IRON PIPE STAKE FOUND

○ = IRON PIPE STAKE SET.

E MYRTLE ROAD.

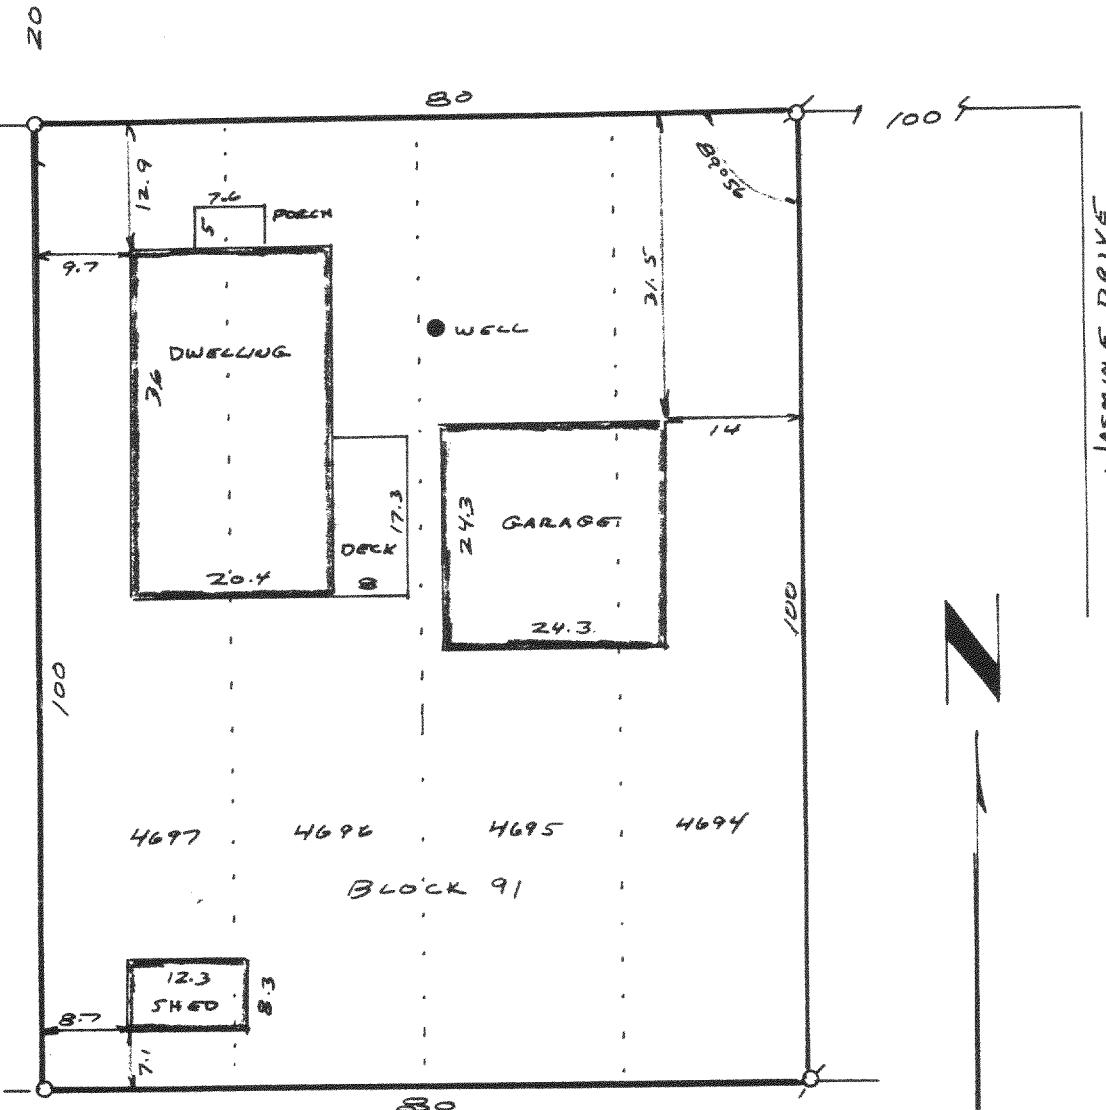

Dated at Burlington, this 14th day
of APRIL, 1993

John F. Degen
John F. Degen, Land Surveyor S 242
589 N. Pine St. Burlington, WI 53105

