
PLAT OF SURVEY

Lots 618 thru 622, Block 15 of PELL LAKE HIGHLANDS, being a subdivision located in the Southeast Quarter of Section 16, Township 1 North, Range 18 East of the 4th Principal Meridian, Town of Bloomfield, Walworth County, Wisconsin.

AMBIT LAND SURVEYING P.O. Box 42 Bassett, WI. 53101 414-537-4874

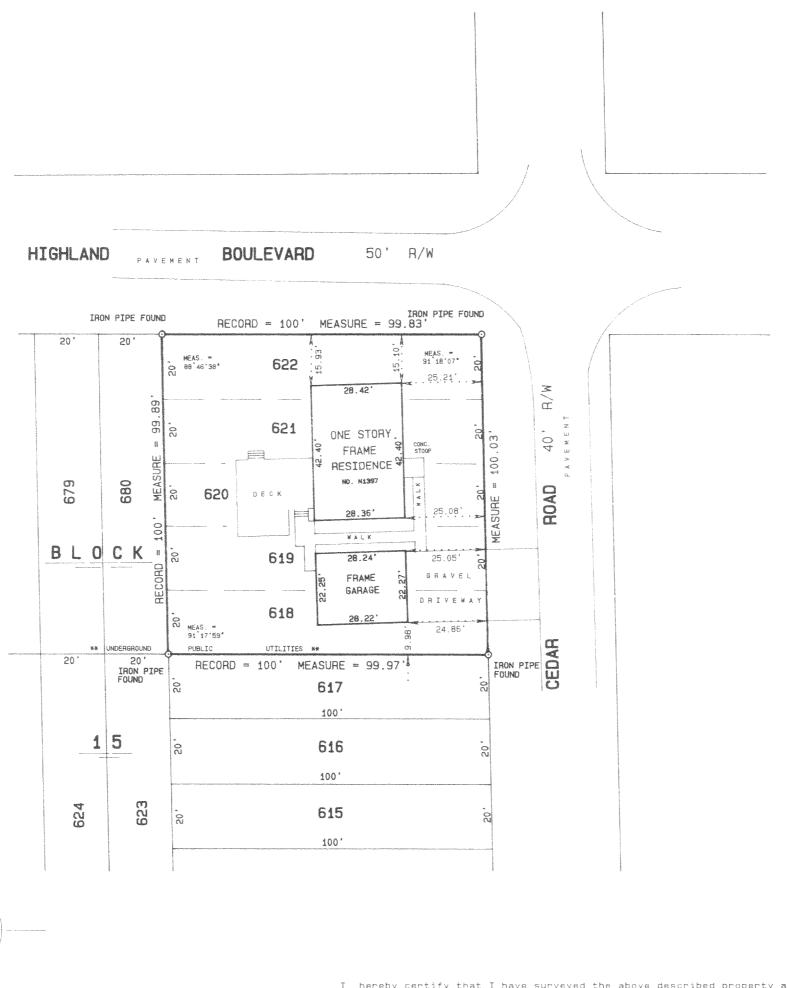

SCALE linch = 30 feet

ORDERED BY D. Anderson / Larry Hodges Realty

JOB NO. 93107

I hereby certify that I have surveyed the above described property and the above plat is a true representation thereof and shows the size and location of the property, its exterior boundaries, the location and dimensions of all visible structures thereon, boundary fences, apparent easements and roadways and visible encrochments, if any.

This survey is made for the exclusive use of the present owners of the property, and also those who purchase, mortgage, or guarantee the title thereto within one year from the date hereof.

Dated at Bassett. Wisconsin this 5 day of APRIL 1993

Mark A. Bolender
Wisconsin Registered Land Surveyor S - 1784

