

Wisconsin Registered Land Surveyor S-1594

Rt. 3, Box 273
Elkhorn, Wisconsin 53121
Phone: (414) 723-4260 (office)
(414) 723-4813 (residence)

PLAT OF SURVEY

LOTS 11 THRU 13 INCLUSIVE LOTS 55 THRU
60 INCLUSIVE OF BLOCK 10 OF LAKE IVANHOE
RESORT LOCATED IN TOWN 1 NORTH, RANGE 18
EAST, WALWORTH COUNTY, WISCONSIN.

OWNER: CHARLES PHINISEE
N. 2486 GILES DR.
BURLINGTON, WI. 53105

B L O C K 1 0

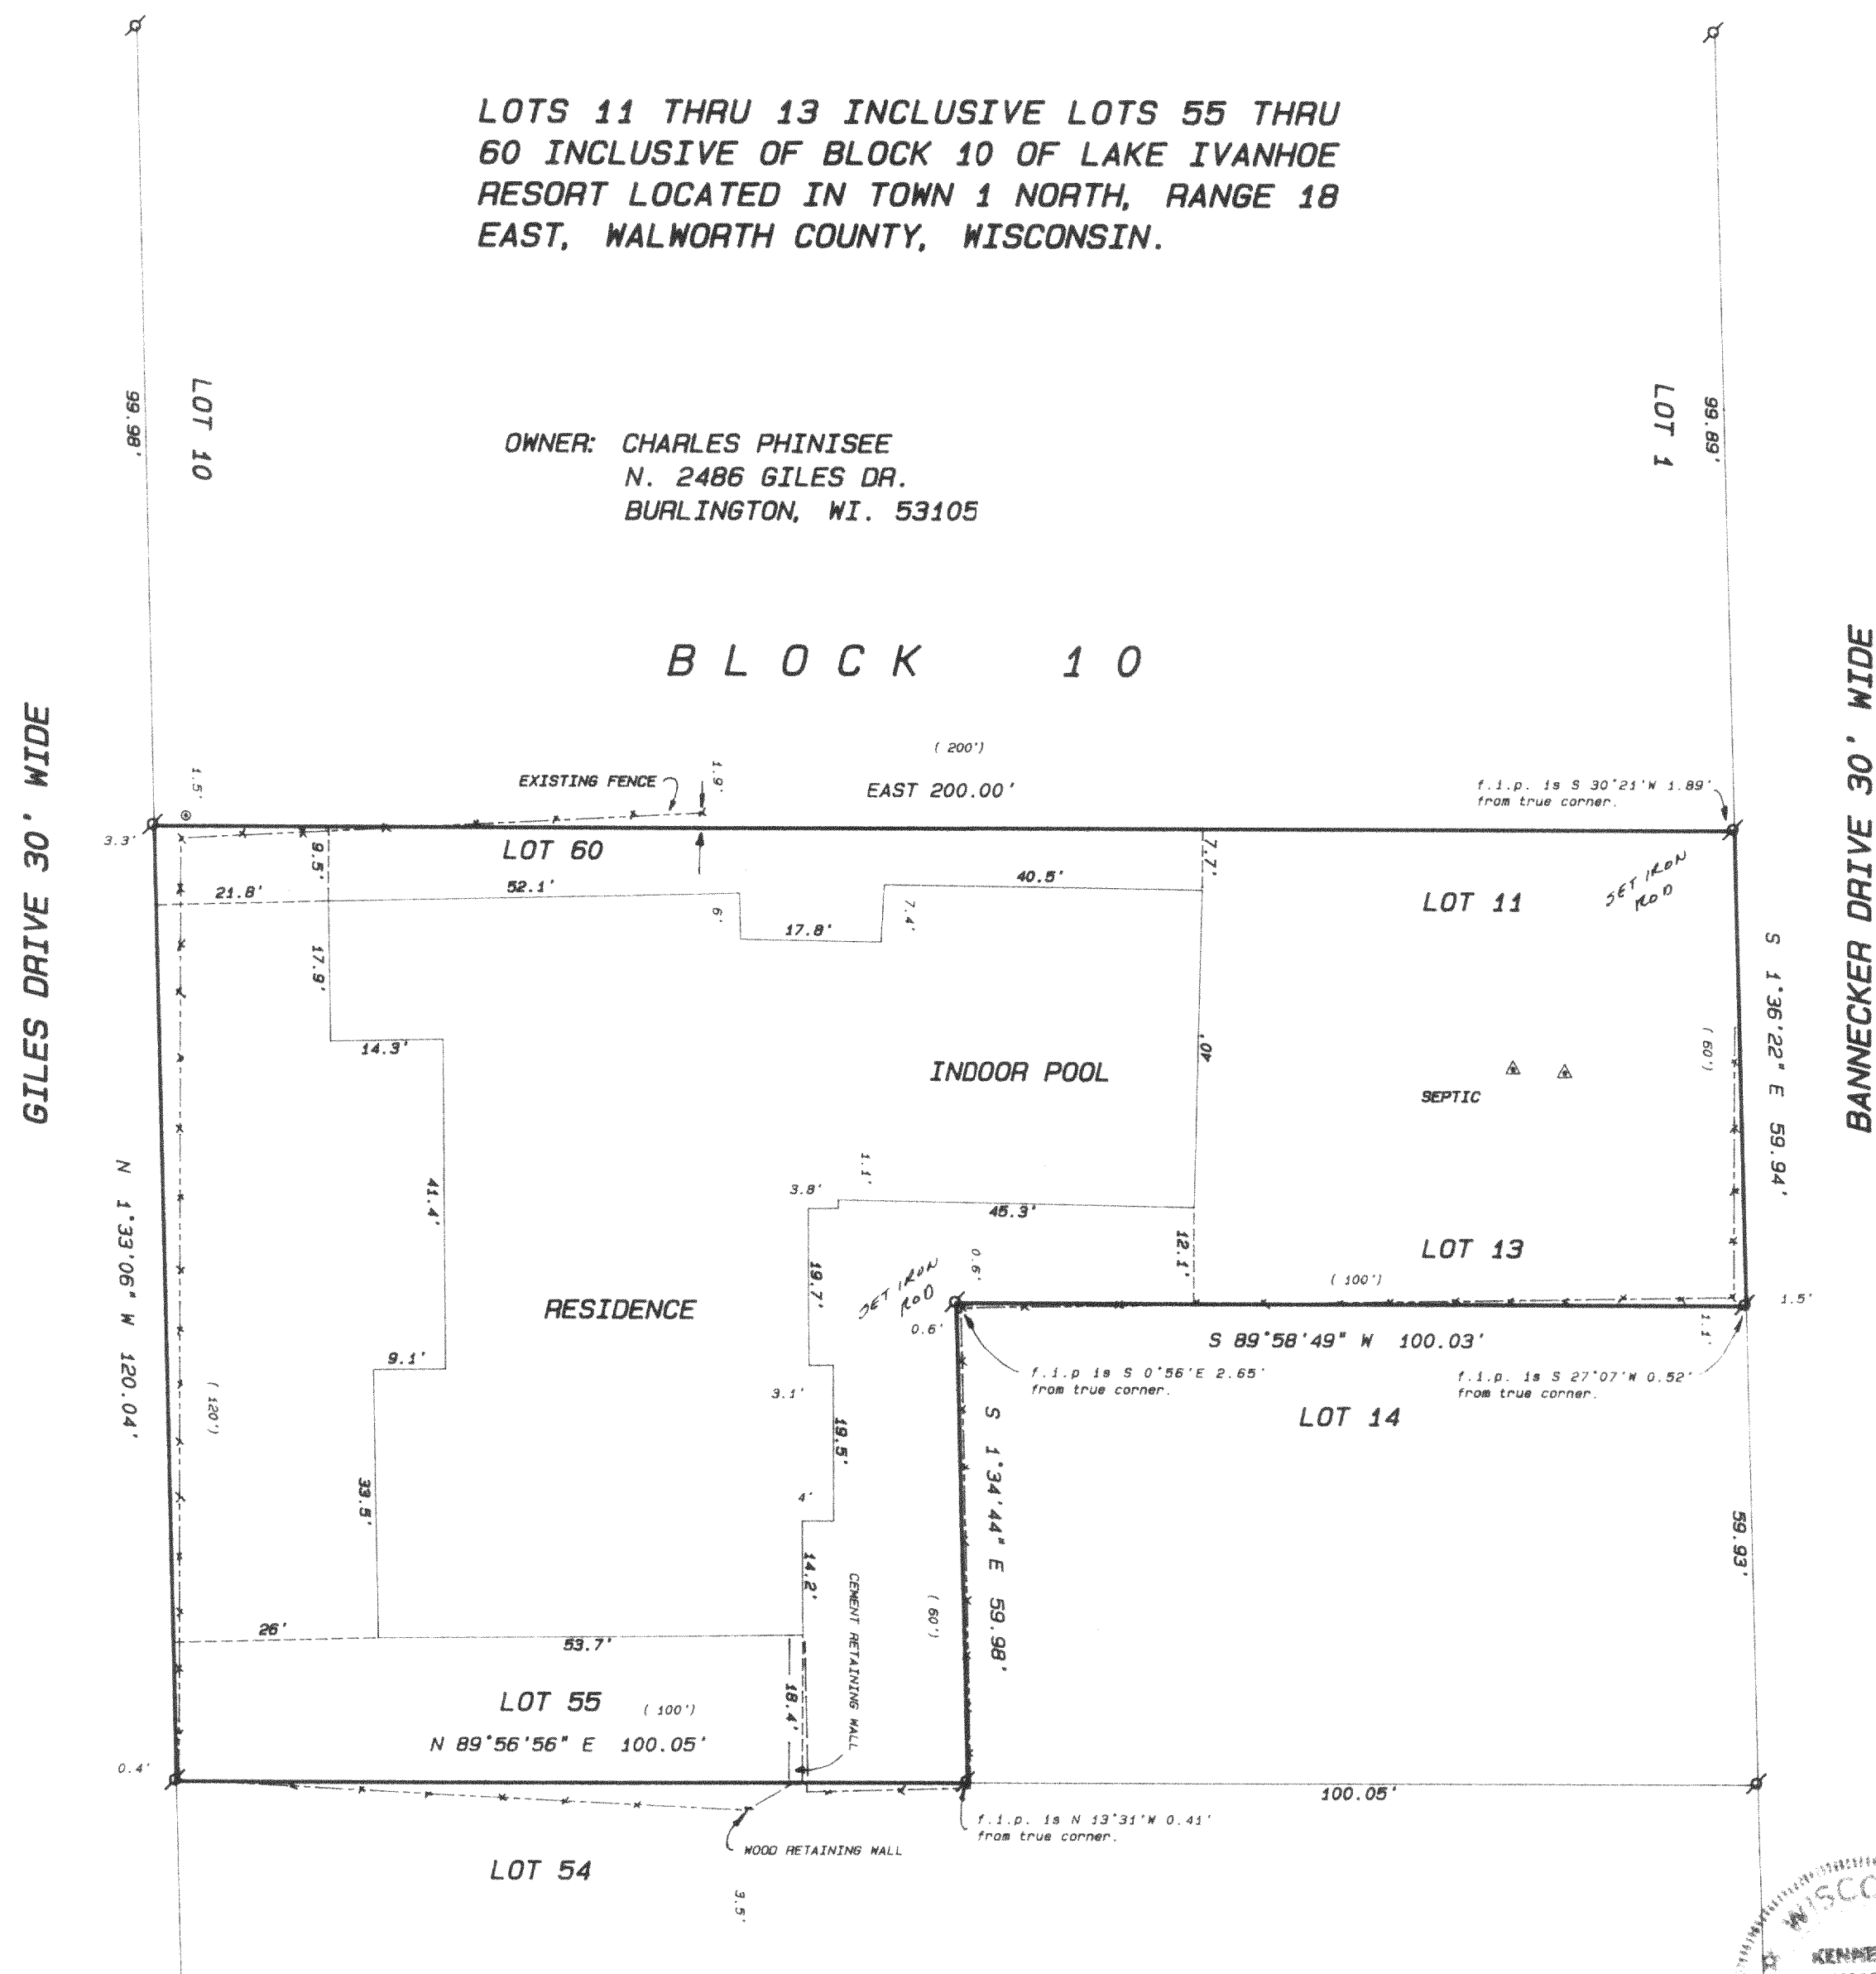


Figure 1 is a schematic diagram of a vertical structure, likely a chimney or tower, showing its internal truss system. The structure is tall and narrow, with a central vertical axis. It features a series of diagonal bracing members forming a truss. At the base, there is a cross-section showing a square or rectangular footprint with internal bracing. A scale bar at the bottom indicates "SCALE 1" = 20 FEET".

Legend

- FOUND IRON PIPE
FOUND IRON ROD
FOUND BRASS CAPPED MONUMENT
FOUND CONCRETE MONUMENT
CHISEL CUT IN CONCRETE
SET IRON ROD, 24" LONG, WEIGHING
1.5 LBS./LINEAL FT., 3/4" DIA.
SET IRON ROD, 30" LONG, WEIGHING
4.5 LBS./LINEAL FT., 1-11/16" DIA.
(xx) RECORDED AS DIMENSION
EXISTING FENCE



SCALE: 1" = 20 FEET

"I hereby certify that I have surveyed the above described property and that the above map is a true representation thereof and shows the size and location of the property, its exterior boundaries, the location of all visible structures and dimensions of all principal buildings thereon, boundary fences, apparent easements, roadways and visible encroachments, if any."

"This survey is made for the use of the present owners of the property, and also those who purchase, mortgage, or guarantee the title thereto within one year from date hereof."

KENNETH B. ABERNATHY, JR.
WISCONSIN REGISTERED LAND SURVEYOR.

Date: 7-27-93 Job No. 93.708

MIR-161
MIR-174

118-1239