
KOLB LAND CONSULTING, INC.

LAND SURVEYING . SUBDIVIDING . LAND PLANNING

929 WILLIAMS STREET

LAKE GENEVA, WISCONSIN 53147

414-248-3697

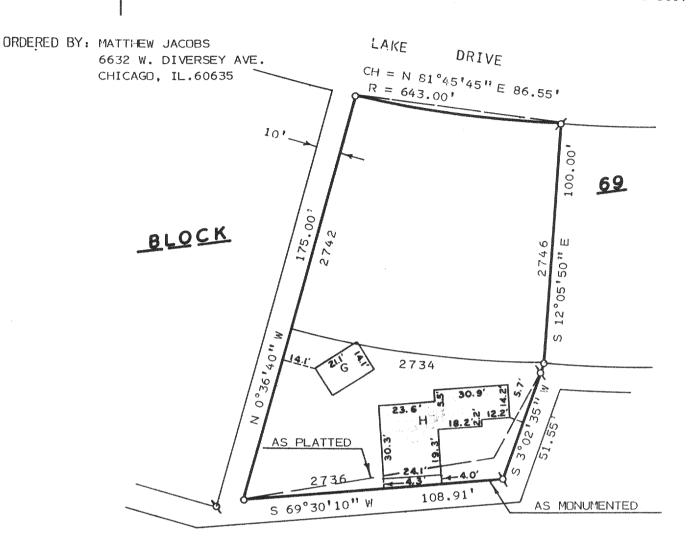

NOTE: BEARINGS ARE ASSUMED AS SHOWN ON RECORDED SUB-DIVISION PLAT.

PLAT OF SURVEY OF

LOTS 2734-2736 AND 2742-2746, BLOCK 69
OF PELL LAKE SUBDIVISION LOCATED IN T1N,
R18E, TOWN OF BLOOMFIELD, WALWORTH COUNTY,
WISCONSIN.




SCALE: 1" = 40' LEGEND

ø - IRON PIPE FOUND

O - IRON PIPE SET

G - GARAGE

H - HOUSE

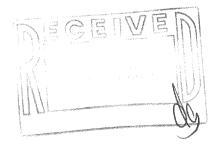

I, HAROLD H. KOLB, DO HEREBY CERTIFY THAT I HAVE SURVEYED THE PROPERTY HEREON DESCRIBED ACCORDING TO THE OFFICIAL RECORDS AND THAT THE PLAT HEREON IS A CORRECT REPRESENTATION OF THE LOT LINES AND THE PRINCIPAL LINES OF THE BUILDINGS TO THE BEST OF MY KNOWLEDGE AND BELIEF. SURVEY NOT VALID UNLESS SURVEYOR'S SIGNATURE IS IN RED.

| HAROLD | H. | KOLB | | | | |
|---------|----------|-------|-------|------|-----------|---|
| WISCON | SIN | REGIS | TERED | LAND | SURVEYOR, | S-187 |
| DATE | <u> </u> | TOBER | 19, 1 | 993 | | managa na invisorate managa na indiana na ind |
| REVISED | | | | | | |
| REVISED | | | | | | |